


G-9592

53860

T.26S.,R.15E.,W.M.

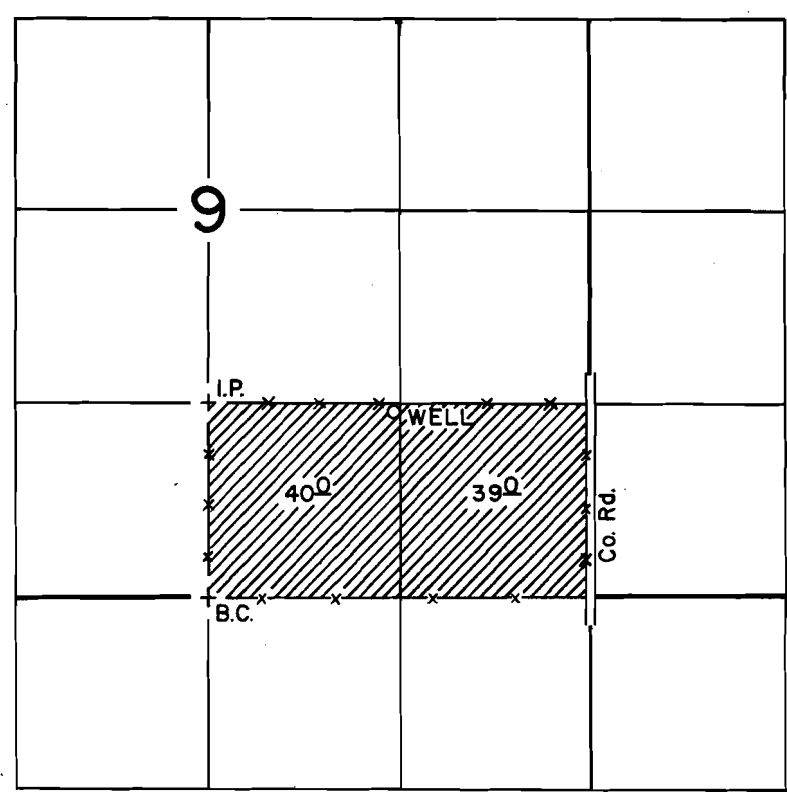

DIV. PT. LOC: 1280'N. & 1280'E. FROM THE S. 1/4 CORNER SEC. 9

SCALE: 1"=1320'

FINAL PROOF SURVEY

UNDER

Application No. G-10158.. Permit No. G-9592....
IN NAME OF

.....MONTY JELDEN.....

Surveyed SEPT. 12.. 1985., by J. WARREN.....