
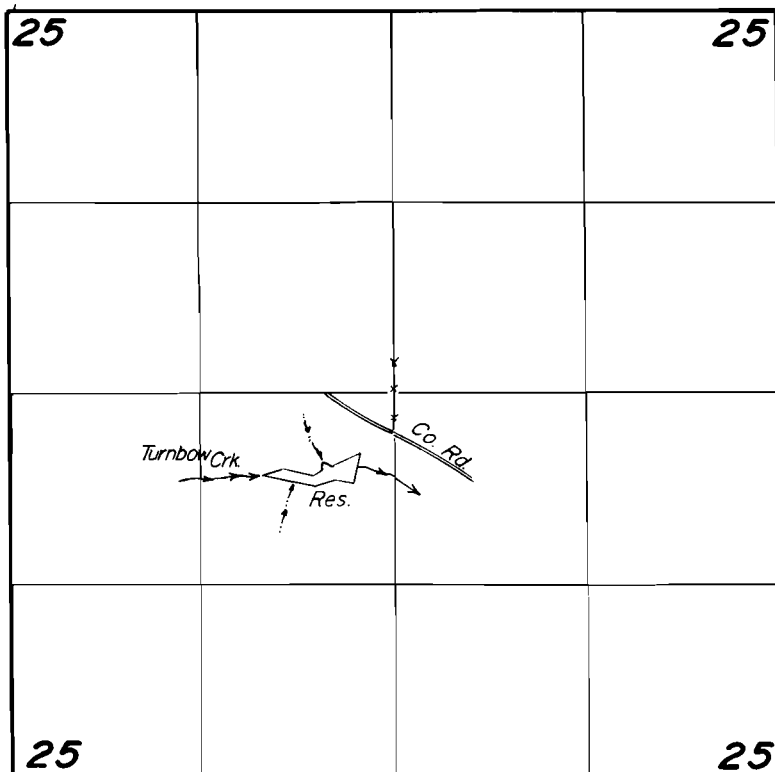


T. 15 S., R. 6 W., W. M.

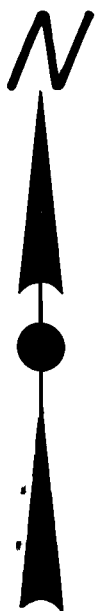

Div. Pt. Loc.: 510' S. & 260' E. from C. 1/4 Sec. 25.

Scale: 1" = 1320'

FINAL PROOF SURVEY **UNDER**

R-58172 R-8131
Application No. *58173*... Permit No. *44867*....
IN NAME OF

HAROLD G. PFEIFFER

Surveyed *May...6...* 19*85*, by *...P...Pagter.....*