


T.17 S., R.9 W., W.M.

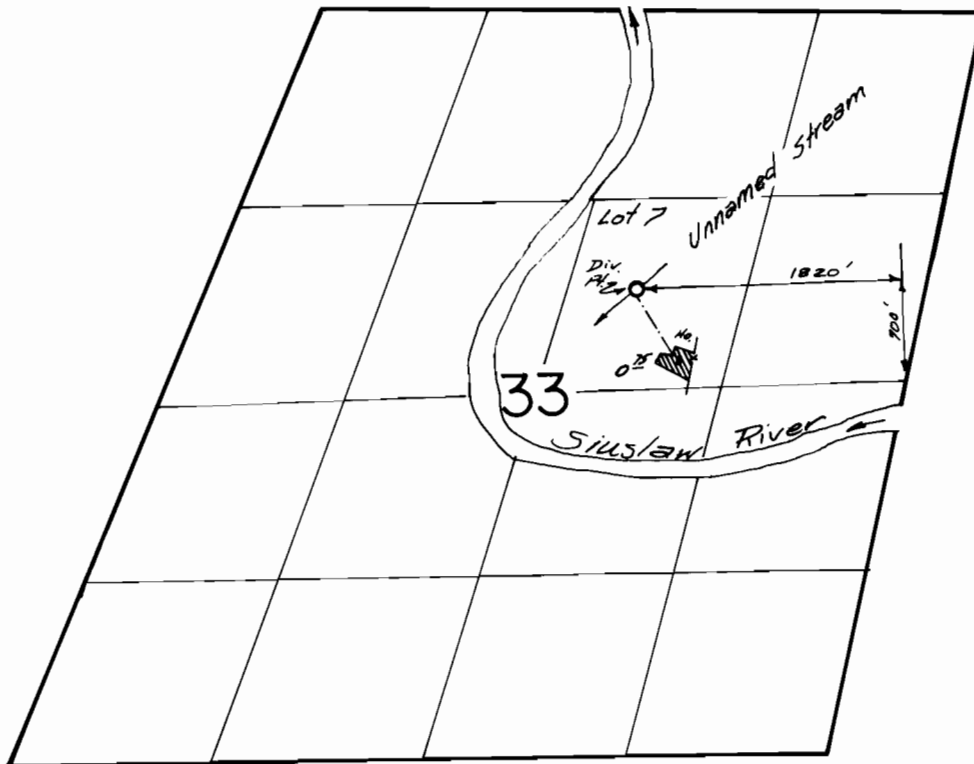

FINAL PROOF SURVEY
UNDER

Application No. 43282 Permit No. 32207

IN NAME OF

Fred E. Holtz

Surveyed May 25 1979, by R.G. MUCKEN