


T.17S., R.9W., W.M.

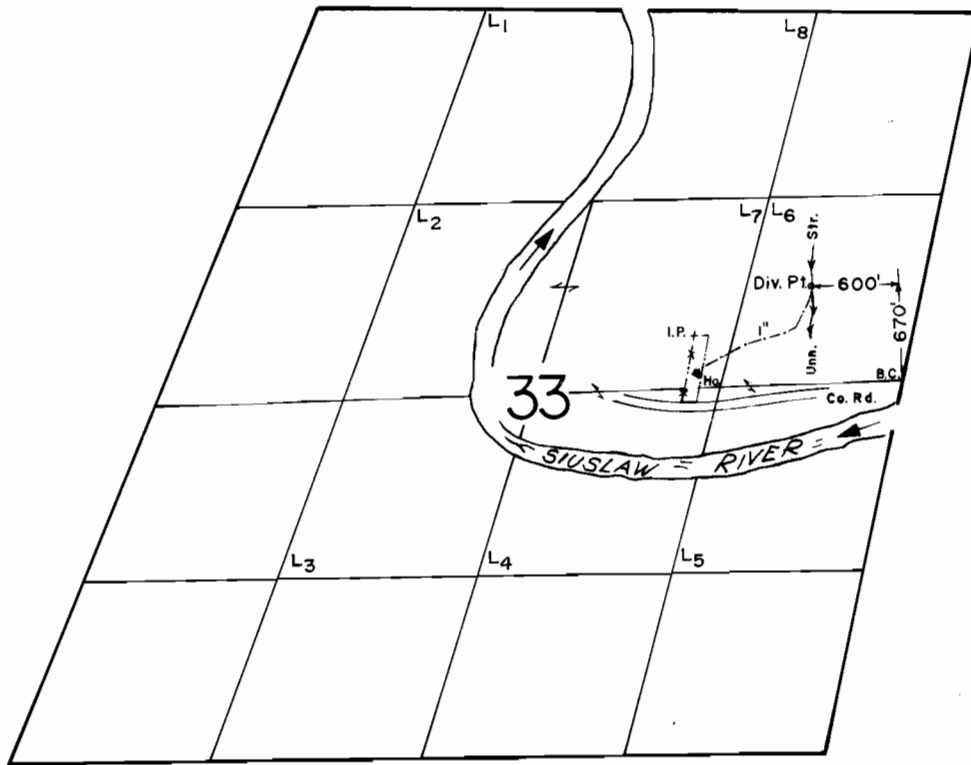

Scale: 1" = 1320'

FINAL PROOF SURVEY
UNDER

Application No. 63493.. Permit No. 46666.....
IN NAME OF

.....BRUCE H. CLARK.....

Surveyed Sept. 25.. 19.85., byT. Warren.....