

Application No. 65341  
Permit No. 49017

**RECEIVED**

OCT 7 1983

WATER RESOURCES DEPT.  
SALEM, OREGON

26

T221S

Chlorinator

Diversion Point


Pipe Line  
BM 2079

Blue Pool  
Forest Camp

McCredie Spring

N

R 4 E

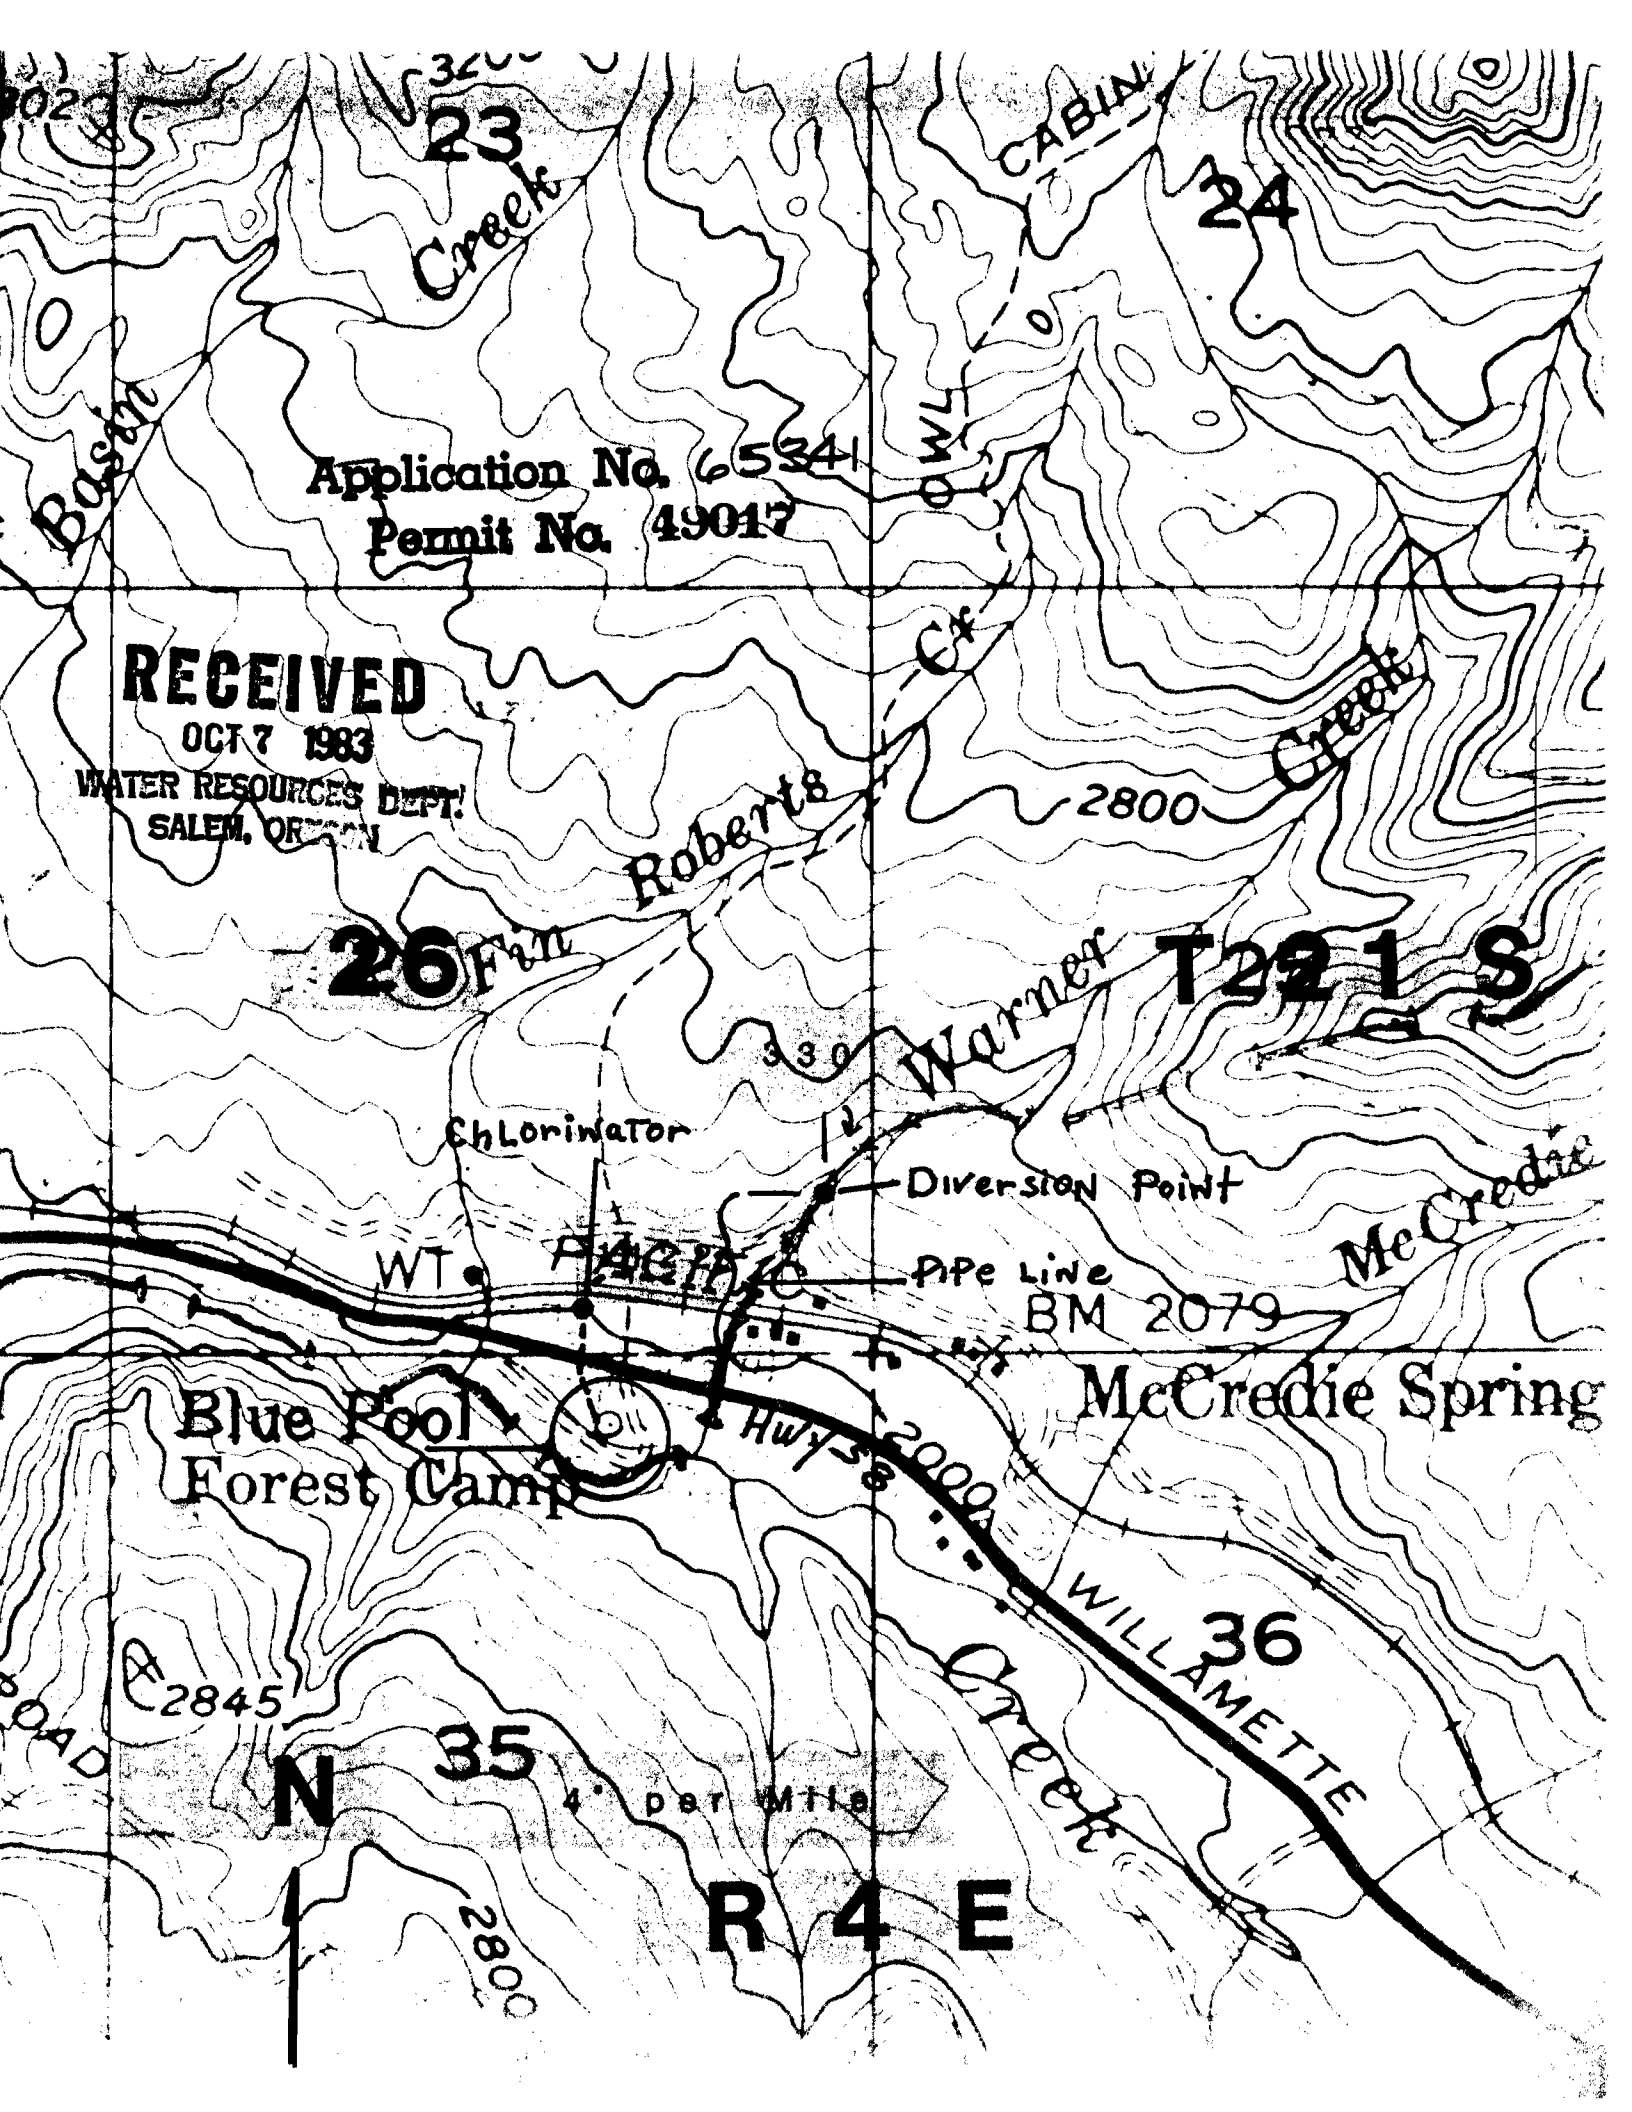

# BLUF POOL CAMPGROUND

