


T.14S., R.3W., W.M.

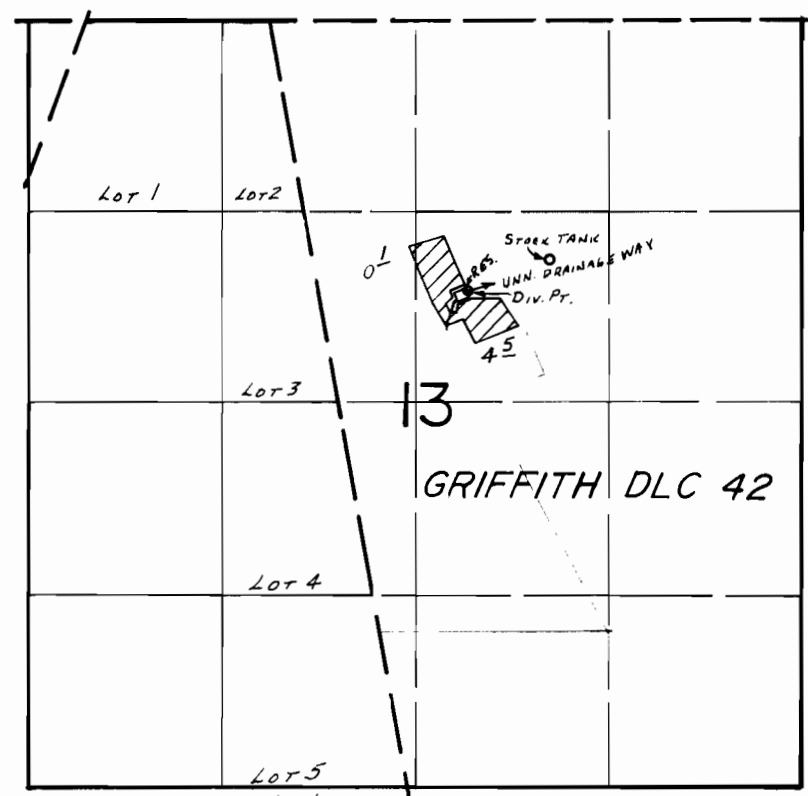

DIV. PT. LOC.: 1850'S & 1350'E. FROM NW COR. GRIFFITH DLC 42.

SCALE: 1" = 1320'

FINAL PROOF SURVEY UNDER

R-58978 R-7930
Application No. 58979... Permit No. 44396.....
IN NAME OF

.....DAVID J. COLLINS.....

Surveyed June 12... 1984, by L.M. TOLL.....