


# T.11S., R.4W., W.M.

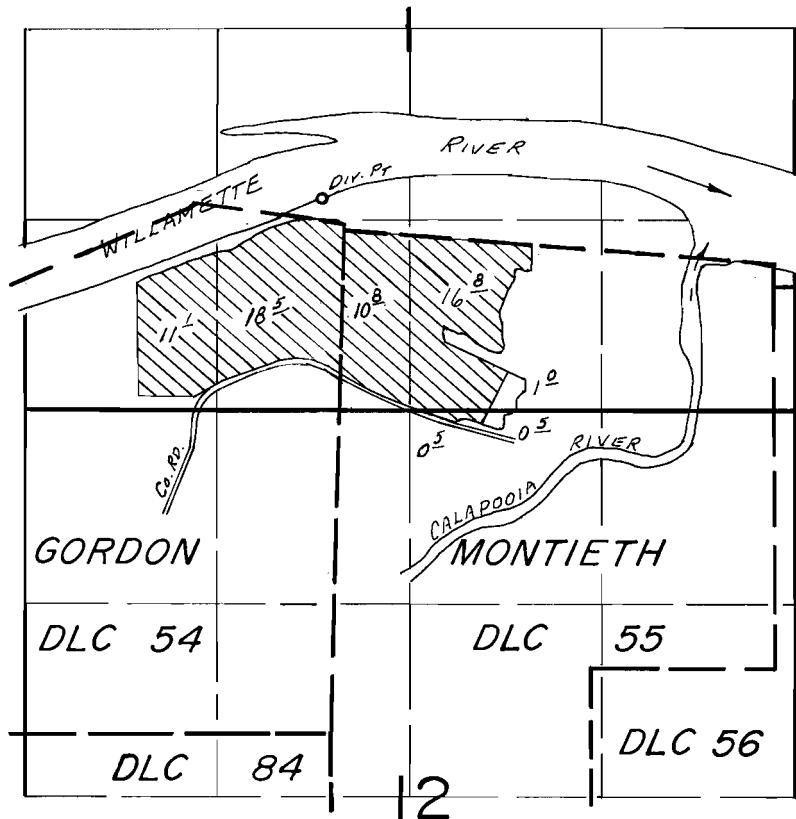

Div. Pt. Loc.: 220' N. & 150' W. FROM NW COR. MONTIETH DLC 55.

SCALE: 1" = 1320'

## FINAL PROOF SURVEY UNDER

Application No. 60040. Permit No. 46321.....  
IN NAME OF

FLOYD M. & DOROTHY F. HOPEMAN

Surveyed May 3..... 19.84, by L.M.TOLL.....