


T.13S., R.1W., W.M.

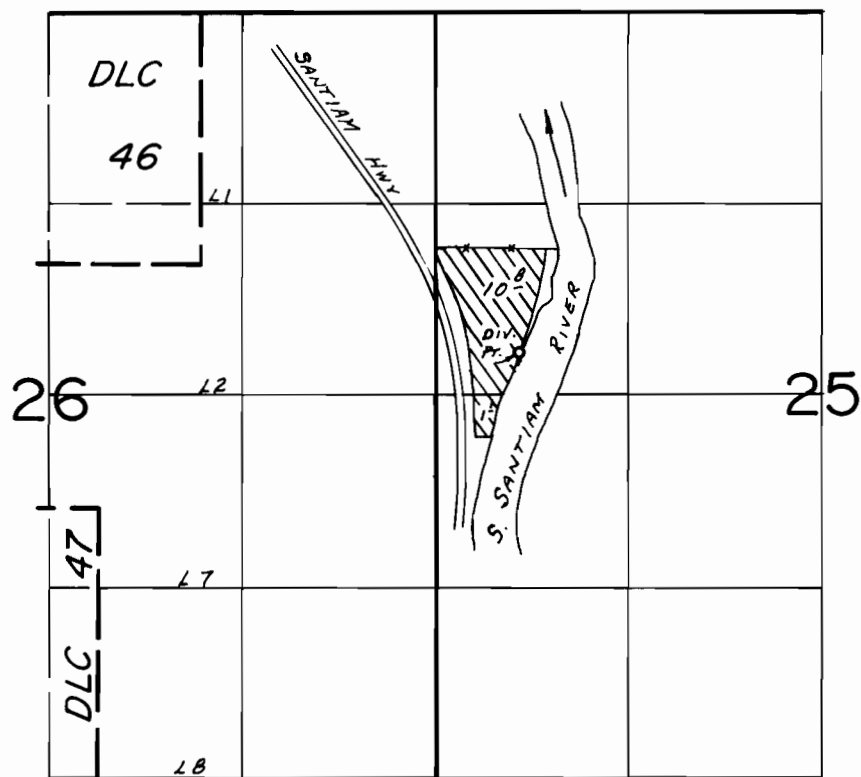

DIV. PT. LOC.: 280 N. 1570 E. FROM N. 1/4 COR. SEC. 25.

SCALE: 1" = 1320'

FINAL PROOF SURVEY UNDER

Application No. 56114... Permit No. 42238.....
IN NAME OF

.....FRANK L. HUMPHREY.....

Surveyed Aug. 1.... 19.79, by S.C. BROWN.....