


T.11S.R.3W.W.M.

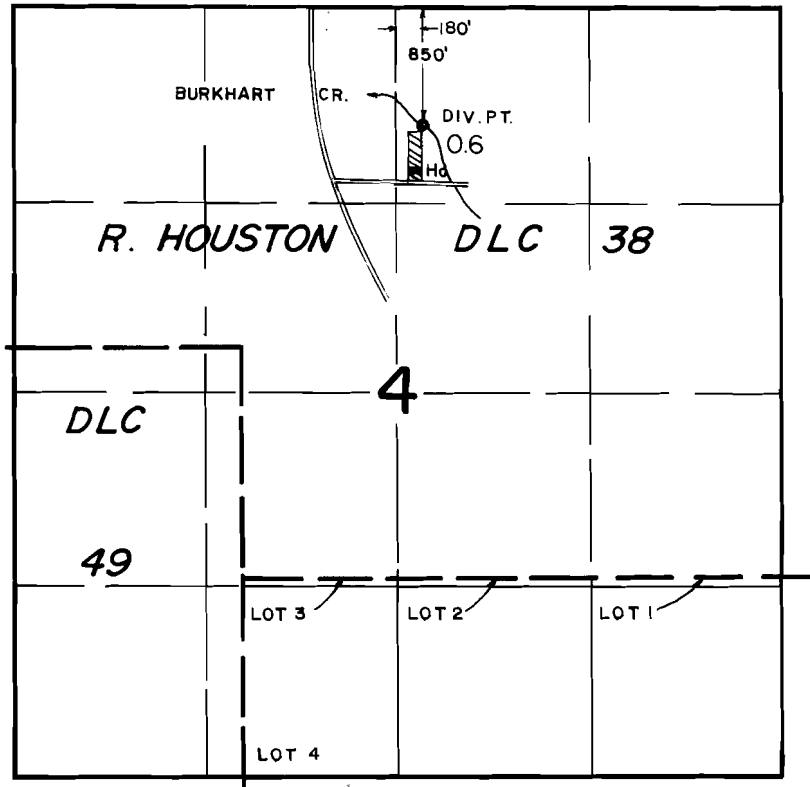

FINAL PROOF SURVEY UNDER

Application No. 5.706.4. Permit No. 42920.....
IN NAME OF

.....ALVIN L. FENN.....

Surveyed April. 24. 1979., by S.C.BROWN.....