


T. 11S. R. 2W. W.M.

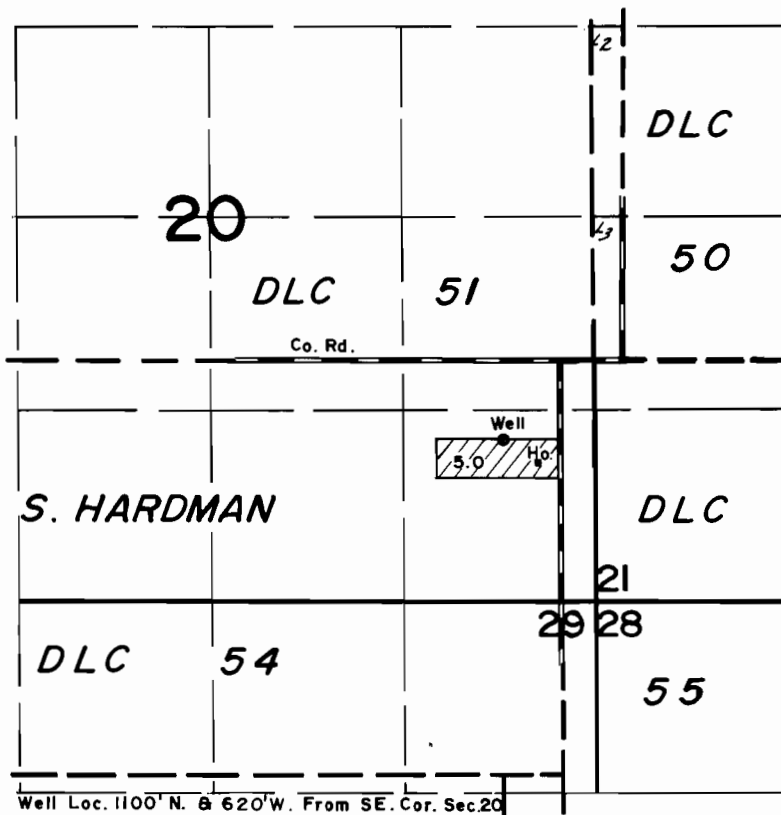

SCALE: 1" = 1320'

FINAL PROOF SURVEY UNDER

Application No. G-9102. Permit No. G-8556....
IN NAME OF

.....SAMUEL & MARIE V. ALLEN.....

Surveyed July....31. 19.79, by S.C. BROWN.....

11-4-85 BJB

PTS-1979-B GRB.