


T.12S., R.2W., W.M.

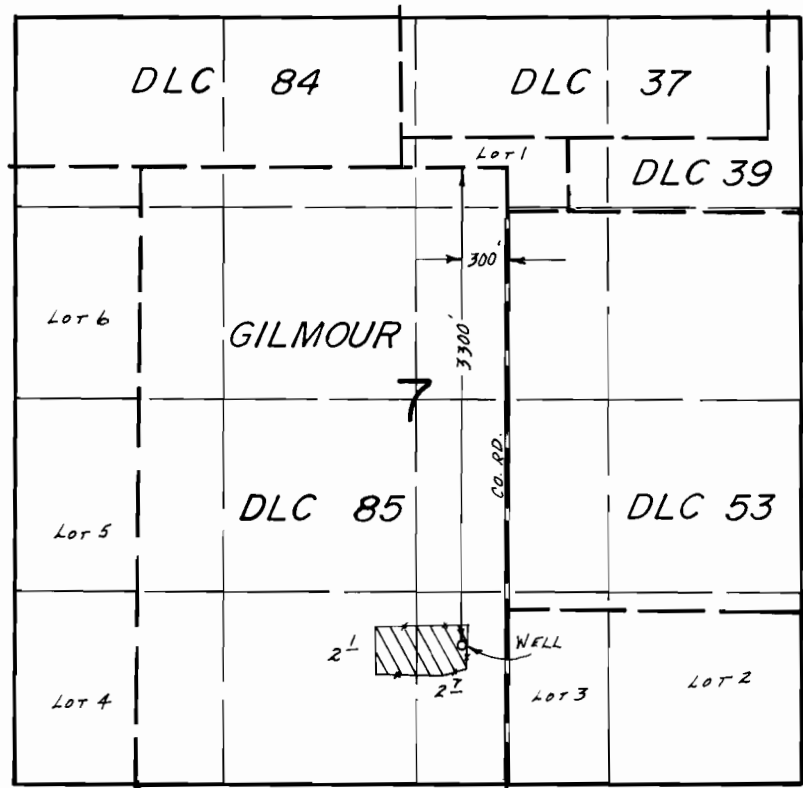

SCALE: 1" = 1320'

## FINAL PROOF SURVEY

UNDER

Application No. G-10564 Permit No. G-9702.....  
IN NAME OF

LAWRENCE & PAULINE KOPP.....

Surveyed June 6.... 1984, by L.M. TOLL.....