


T.9S., R.3E., W.M.

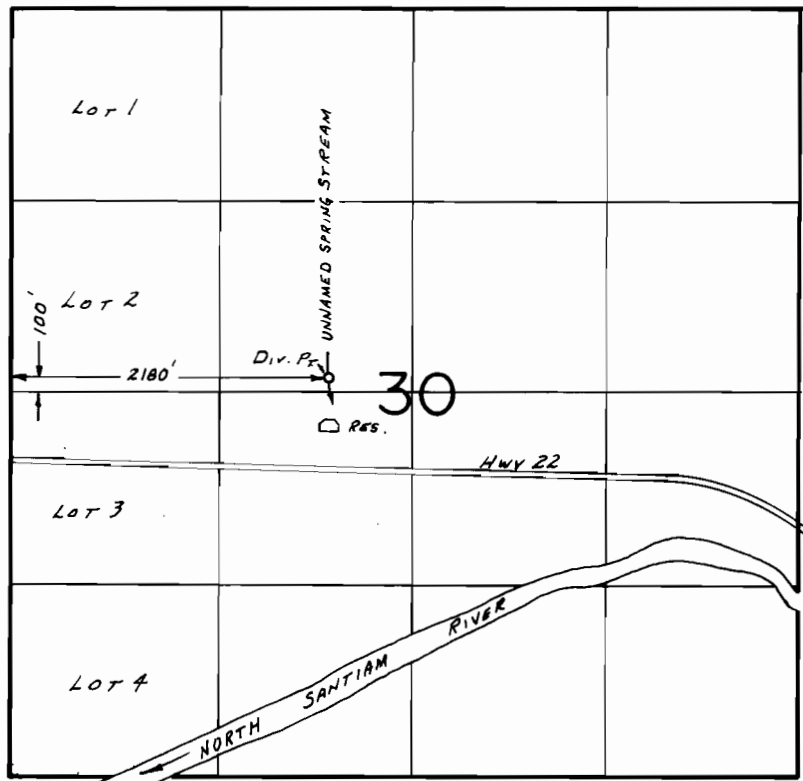

SCALE: 1" = 1320'

FINAL PROOF SURVEY
UNDER

R-56830 R-6764
Application No. 56831 Permit No. 42633
IN NAME OF

.....CHARLES W. BELLEK.....

Surveyed April 25, 1985, by P.R. PASTER.....