


# T.9S., R.3E., W.M.

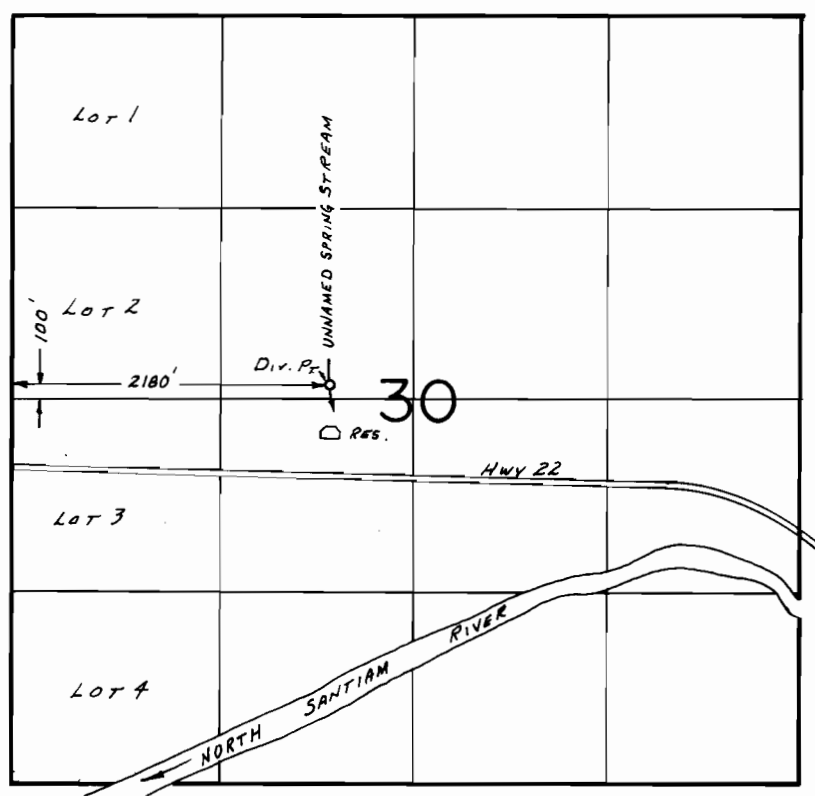

SCALE: 1" = 1320'

## FINAL PROOF SURVEY UNDER

R-56830                      R-6764  
 Application No. 56831 Permit No. 42633  
 IN NAME OF

CHARLES W. BELLEK

Surveyed April 25, 1985, by P.R. PASTER

PTS (ENDURO)  
41043-178-59A *PWB*