


T.6&7S., R.1E., W.M.

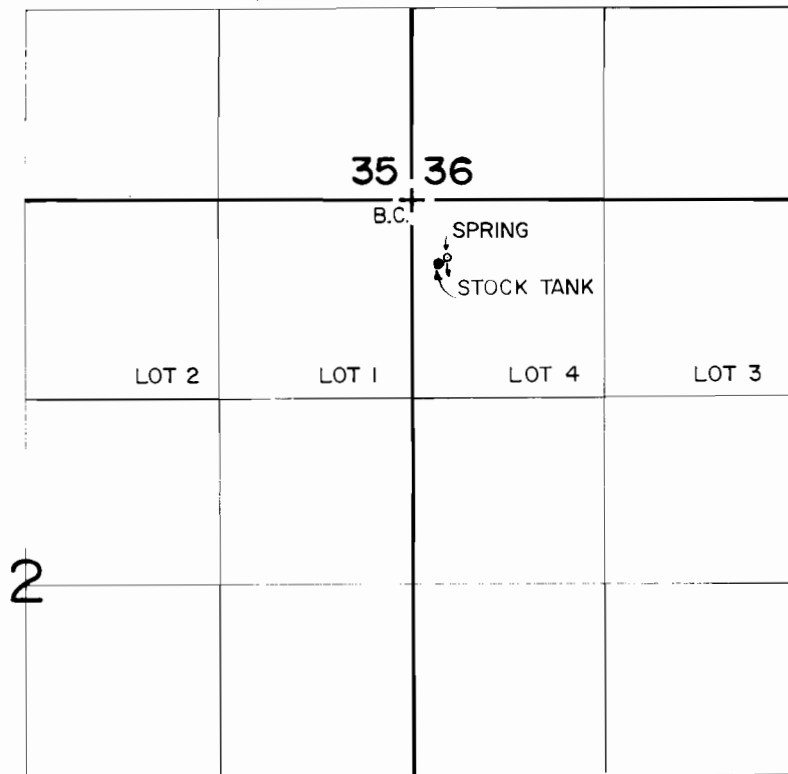

SPRING LOC.: 400' S. AND 240' EAST FROM N.W. COR. OF SEC. 1.

SCALE: 1" = 1320'

FINAL PROOF SURVEY UNDER

Application No. 49661 Permit No. 37185
IN NAME OF

FRANKLIN SHEPHERD

Surveyed AUG. 19. 1985, by B.W. BISHOP