


T. 7S., R. 1E., W.M.

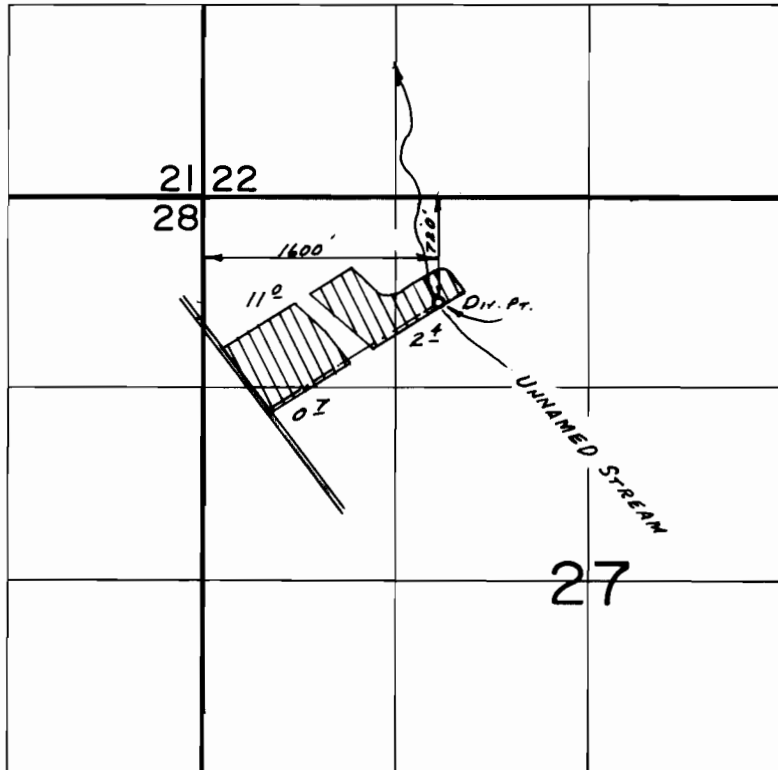

SCALE: 1"=1320'

FINAL PROOF SURVEY UNDER

Application No. 54929. Permit No. 41198.....
IN NAME OF

CHARLES ALFRED REMILLARD

Surveyed Aug. 22. 19.79, by S.C. BROWN.....