


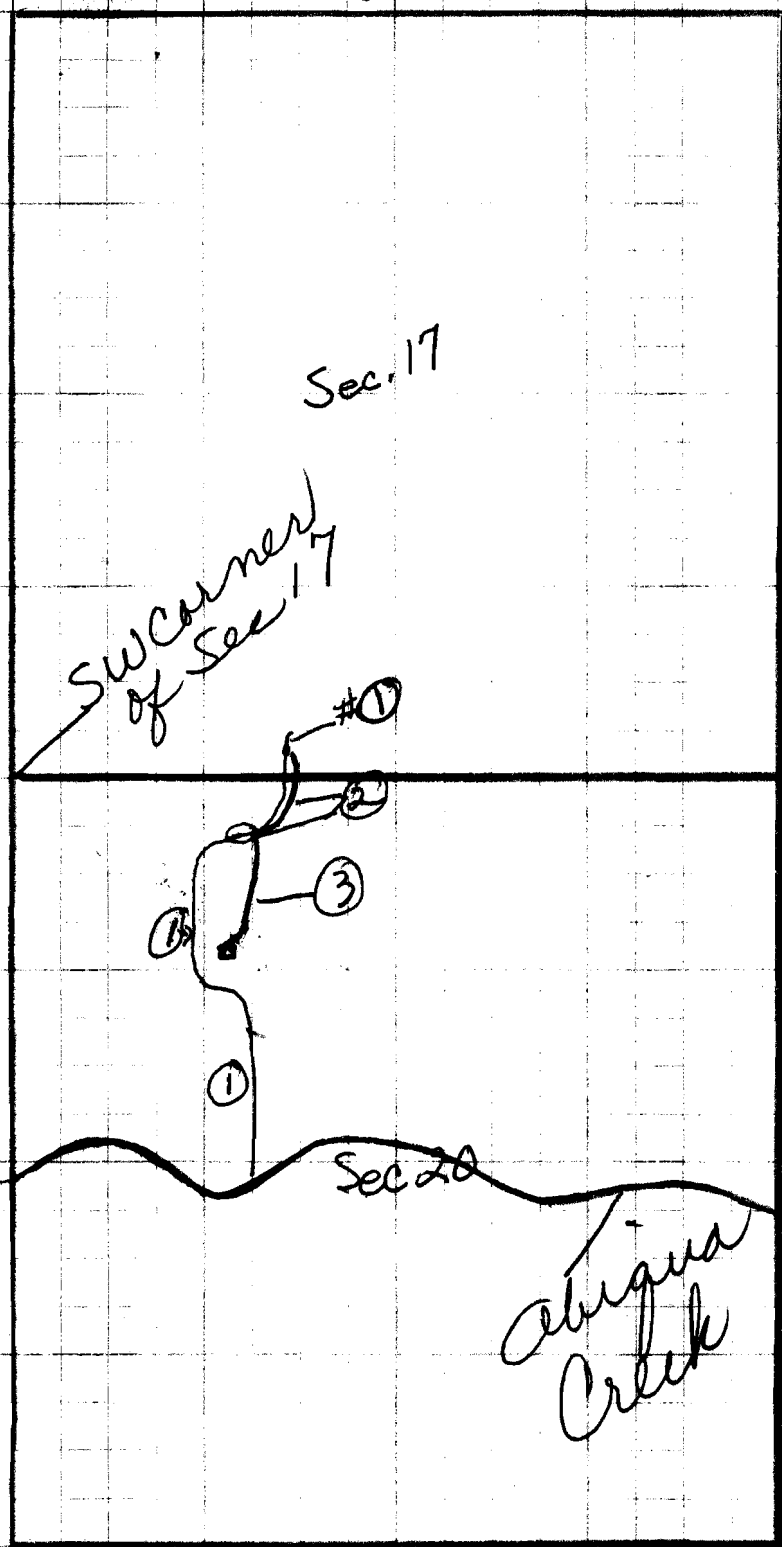

Scale - 4" to a mile

1. unnamed Creek flows south to Abiqua Creek. point of diversion is 1831' east and 271' north from the southwest corner of Sec 17 T7S R2E

The creek is in the SE $\frac{1}{4}$ of the SW $\frac{1}{4}$ of Sec 17 T7S R2E

2. Abiqua City Club 1940 fish pond rights and 4" pipe installed in 1950

3. 1" pipe installed in 1970 to our residence which is in the ~~SE~~ NE $\frac{1}{4}$ of the NW $\frac{1}{4}$ of Sec 20 T7S R2E

Set of 4
Corrected
Maps

RECEIVED

AUG 14 1981

WATER RESOURCES DEPT
SALEM, OREGON

Wm & M. Worley
22606 Milk Ranch Rd.
Scotts Mills, OR 97375