

RECEIVED


SEPS 1976

WATER RESOURCES DEPT.  
SALEM, OREGON

T.8S. R.3W.W.M.

RECEIVED

FEB 10 1982  
WATER RESOURCES DEPT  
SALEM, OREGON

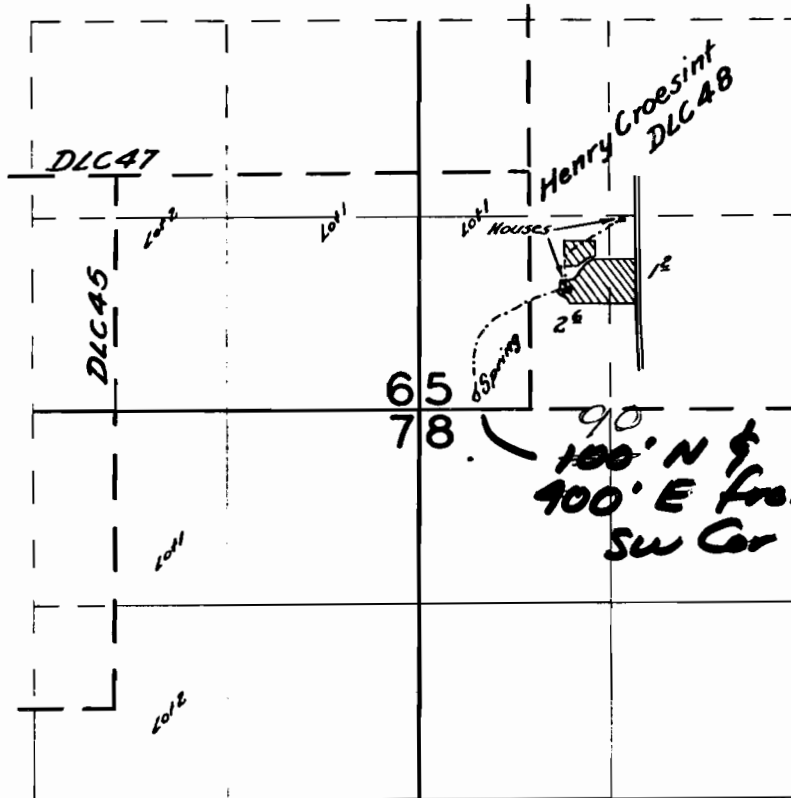

~~Application No. 54757~~  
~~Permit No. 41074~~

Application No. 63251  
Permit No. 46710

FINAL PROOF SURVEY

UNDER

Application No. ~~20393~~ Permit No. ~~16004~~  
IN NAME OF

*Lee Byans*

Surveyed June 4 1956, by *Edith H. H. H.*

DFN-4D-97

Sheet 1 of 2

8.

