


T.9S., R.1E., W.M.

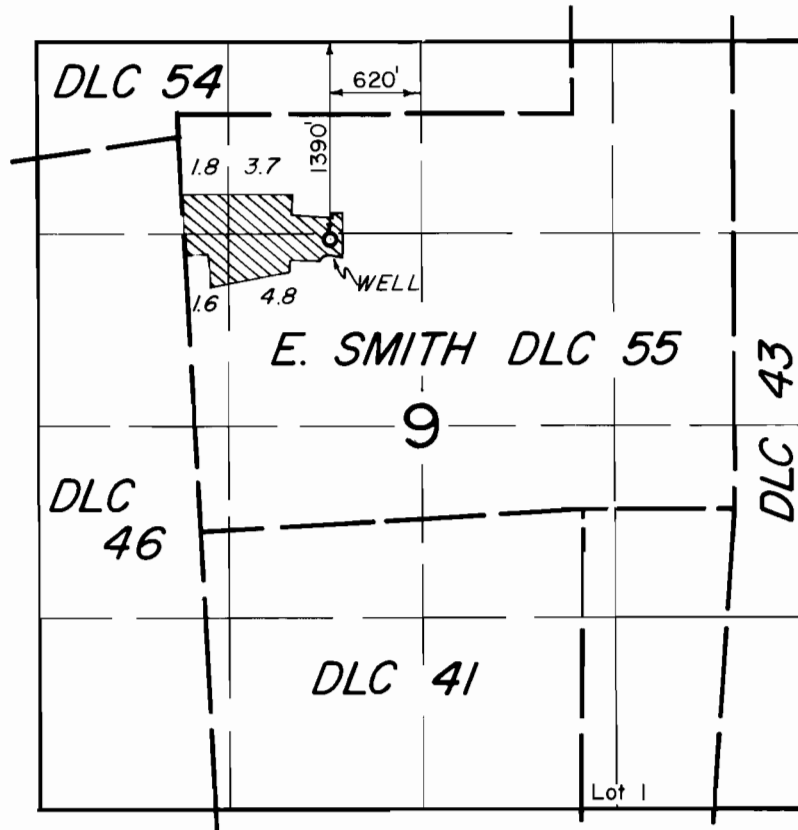

FINAL PROOF SURVEY UNDER

Application No. G-8940 Permit No. G-8290...

IN NAME OF

ALBERT T. PETERS

Surveyed OCT. 4, 1979, by *Alban*