


T.6S., R.3W., W.M.

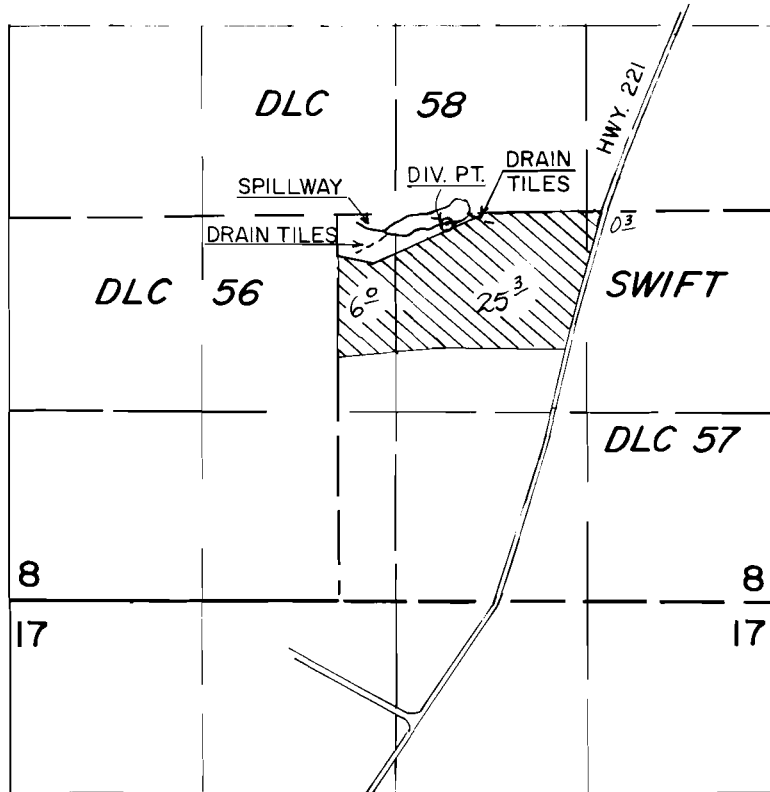

SCALE: 1" = 1320'

FINAL PROOF SURVEY UNDER

R-60708 R-8258
 Application No. 60709 Permit No. 45701.....
 IN NAME OF

GARY DAUM

Surveyed OCT. 2, 1985, by B.W. BISHOP.....