


T. 3S., R. 38E., W. M.

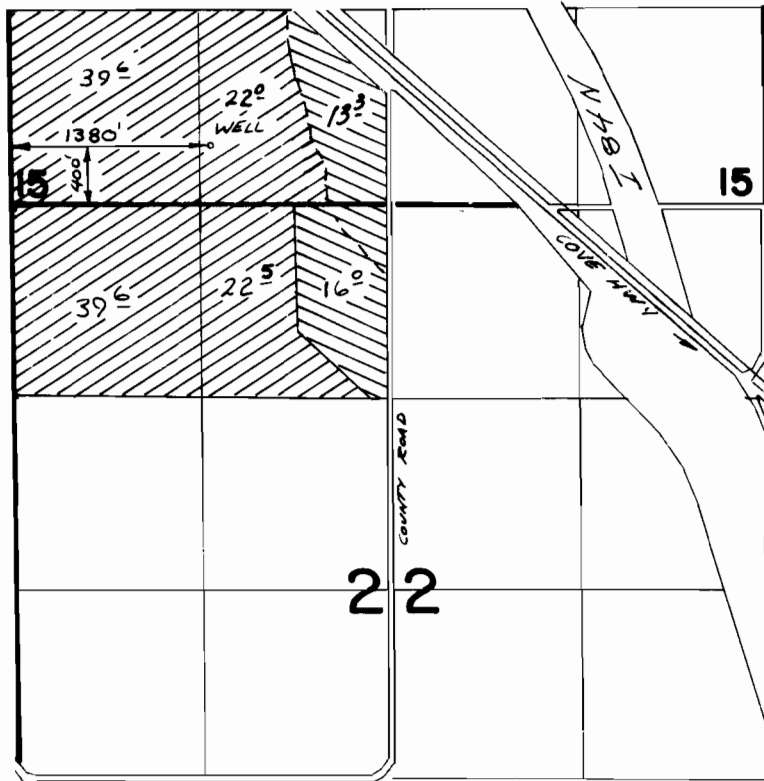

PRIMARY



SUPP'L

FINAL PROOF SURVEY
UNDER

Application No. G-7177 Permit No. G-6700
IN NAME OF

FORREST & RETHA K. BOWMAN

Surveyed 8-22, 23 1979, by V. L. Church & D. J. Lavett