

RECEIVED

SEP 8 1991

WATER RESOURCES DEPT
SALEM, OREGON

RECORD OF SURVEY

FOR

DONALD LOGAN et al
SECTION 6, T 2 N, R 2 W, W. M.

Washington County, Oregon


Scale: 1" = 500' February, 1976

RECEIVED

AUG 5 1982

WATER RESOURCES DEPT.
SALEM, OR

Application No. 62644
Permit No. 47297

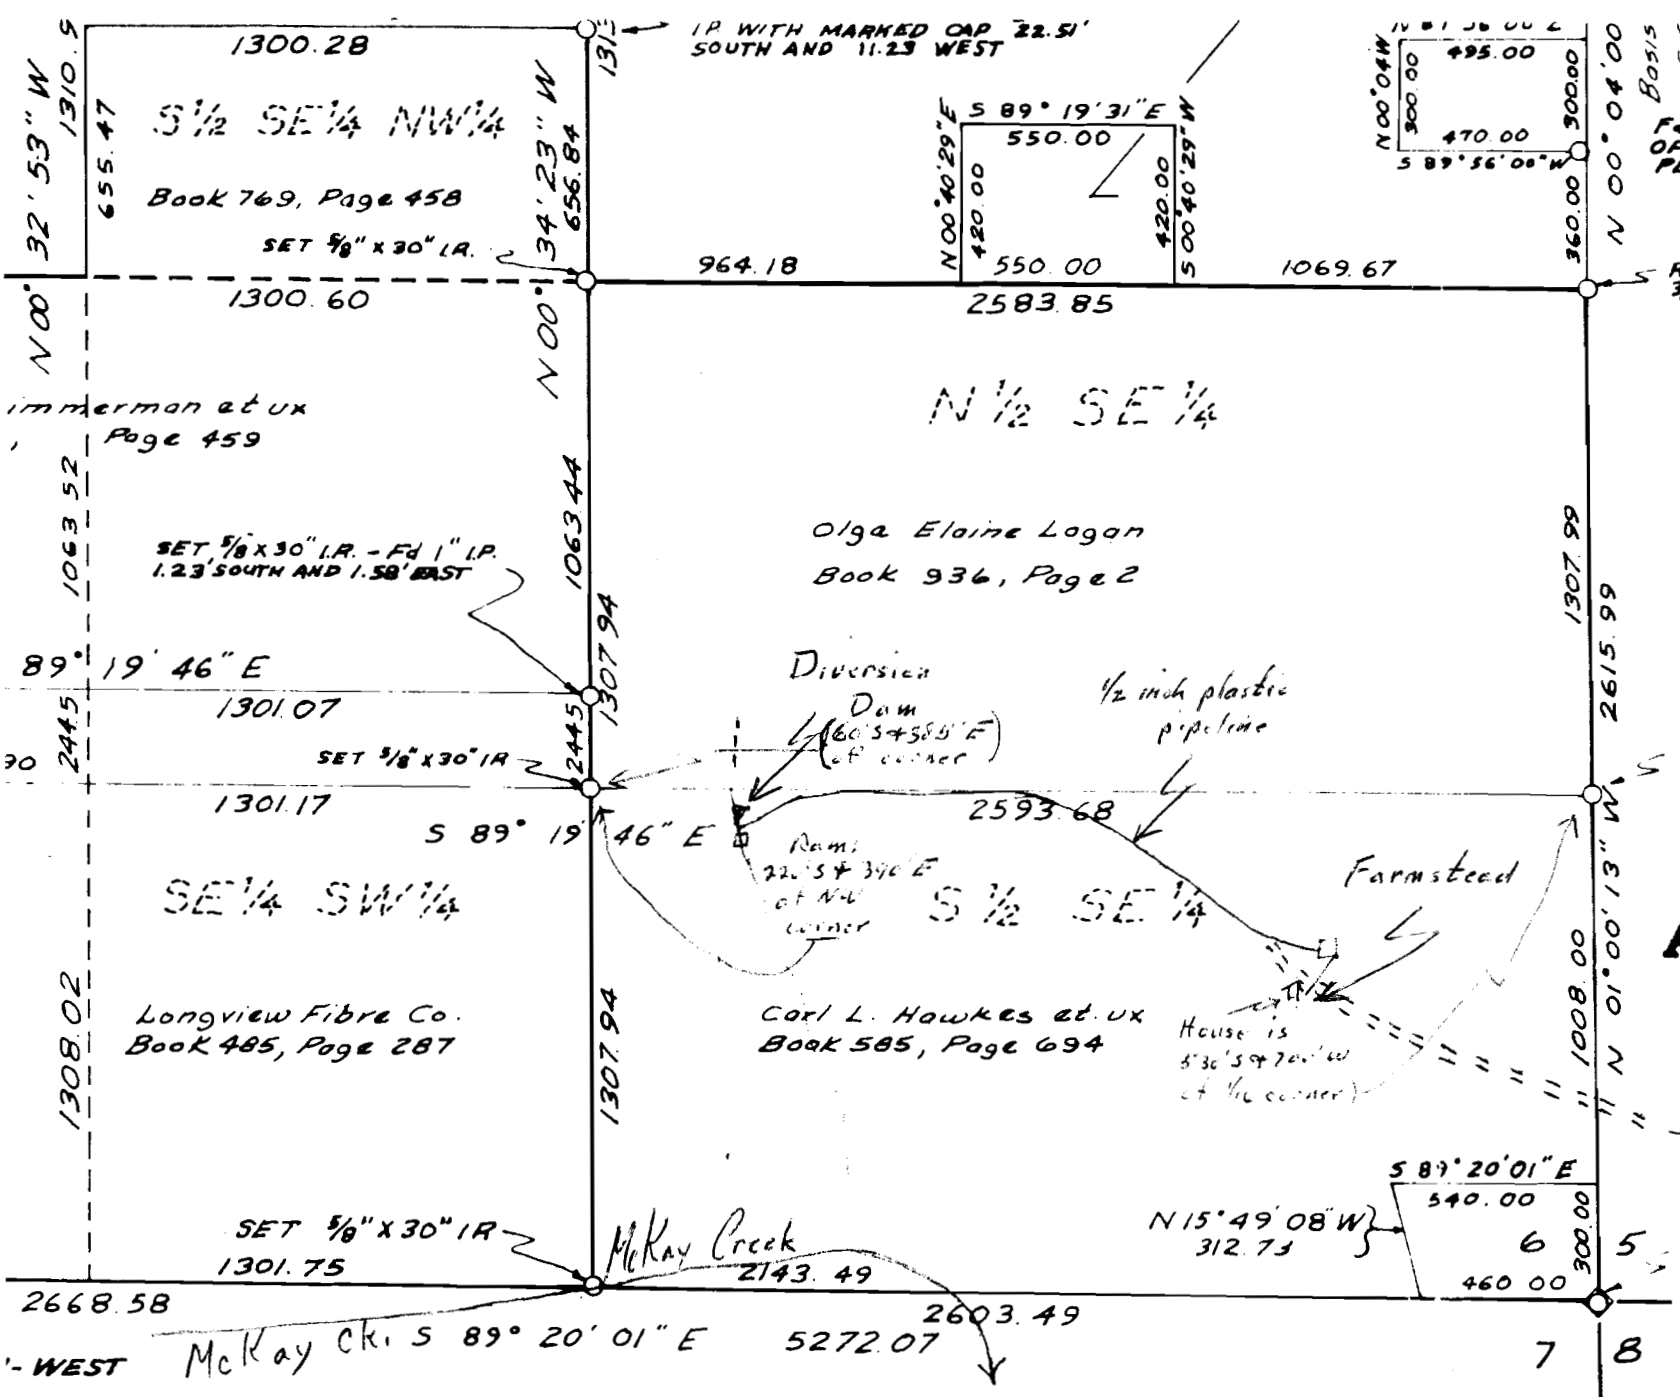

To
Dixie Mt.
Road

5 - Fd. STONE 8" X 5" X 6" ABOVE GRD.
MARKED C.S. - ACCEPTED AS SOUTH-
EAST CORNER SECTION 6