


P-42418
C-53902
53901

T.7S.,R.23&24E.,W.M.

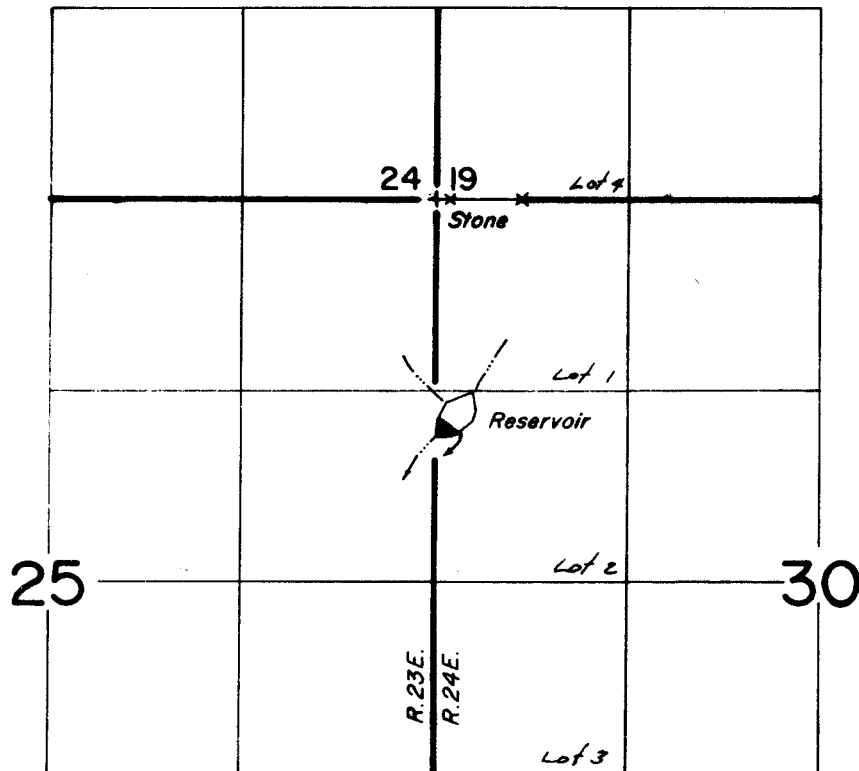

Dam Loc.: 1600 H.S. & 50 H.E., from the NW cor. Sec 30

FINAL PROOF SURVEY
UNDER

R-56491 R-6715
Application No. 56492 Permit No. 42418
IN NAME OF

Michael F. Vandehey

Surveyed SEPT. 12, 1979, by *[Signature]*