


P-39845  
C- 53903

T.7S.,R.24E.,W.M.

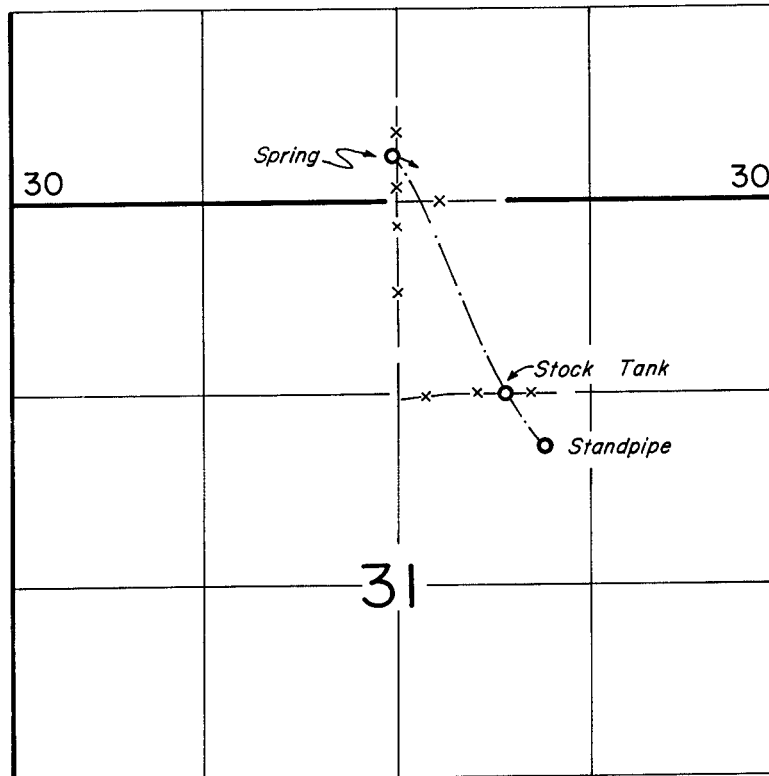

SPRING LOC.: 310' N. & 40' W. from the N 1/4 Corner Section 31

**FINAL PROOF SURVEY**  
UNDER

Application No. 52783.. Permit No. 39845.....  
IN NAME OF

Michael F. Vandehey

Surveyed SEPT. 12., 1979, by *deBour*.....