


P-41103
C-53904

T. 6 S., R. 21 E., W.M.

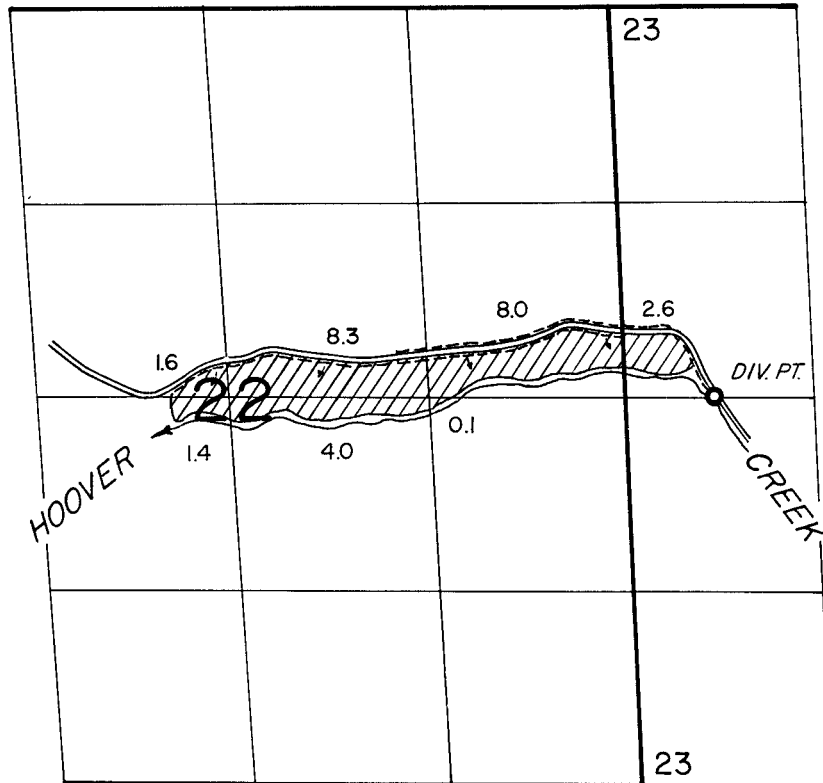

DIV. PT. LOC.: 10' N. & 630' E. From the W. 1/4 Corner Section 23

FINAL PROOF SURVEY
UNDER

Application No. 54780. Permit No. 41103.....

IN NAME OF

MEHRTEN HOMER

Surveyed AUG. 13, 1979, by *Al Brown*