


Application No. 57291
Permit No. 43091

RECEIVED

MAR 29 1978

T.8S., R.24 & 25E., W.M. WATER RESOURCES DEPT.
SALEM, OREGON

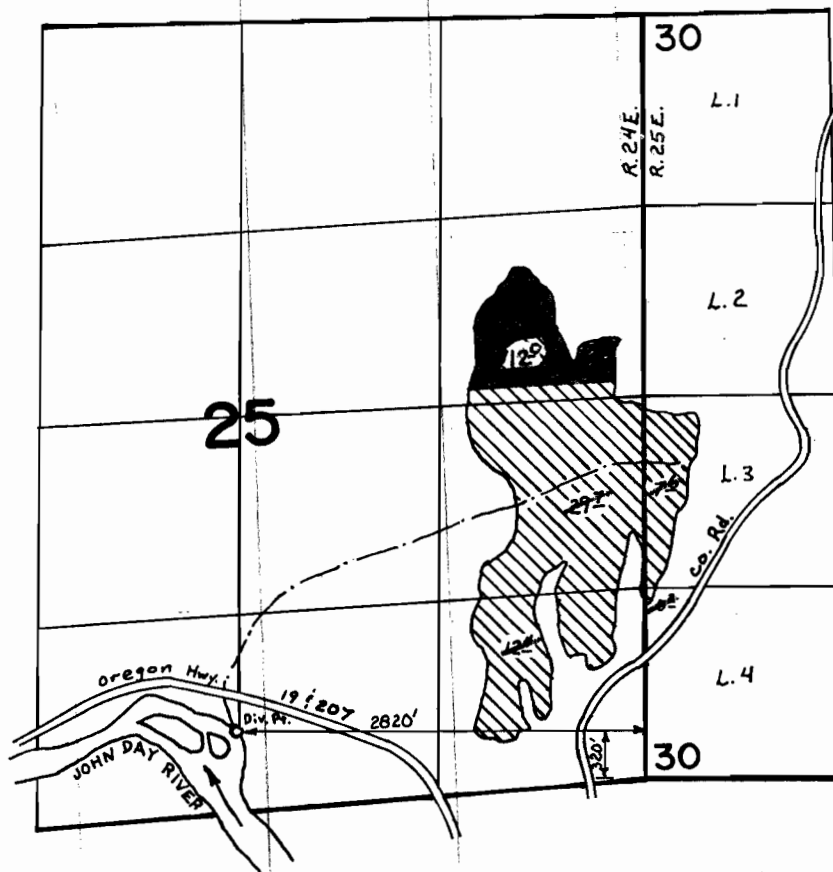

FINAL PROOF SURVEY
UNDER

Application No. ~~52130~~ Permit No. ~~38062~~
IN NAME OF

FRANK CECIL

Surveyed ~~AUG. 21~~ ~~1976~~, by ~~D. NORBY~~