


T.88&9S.,R24&25E.,W.M.

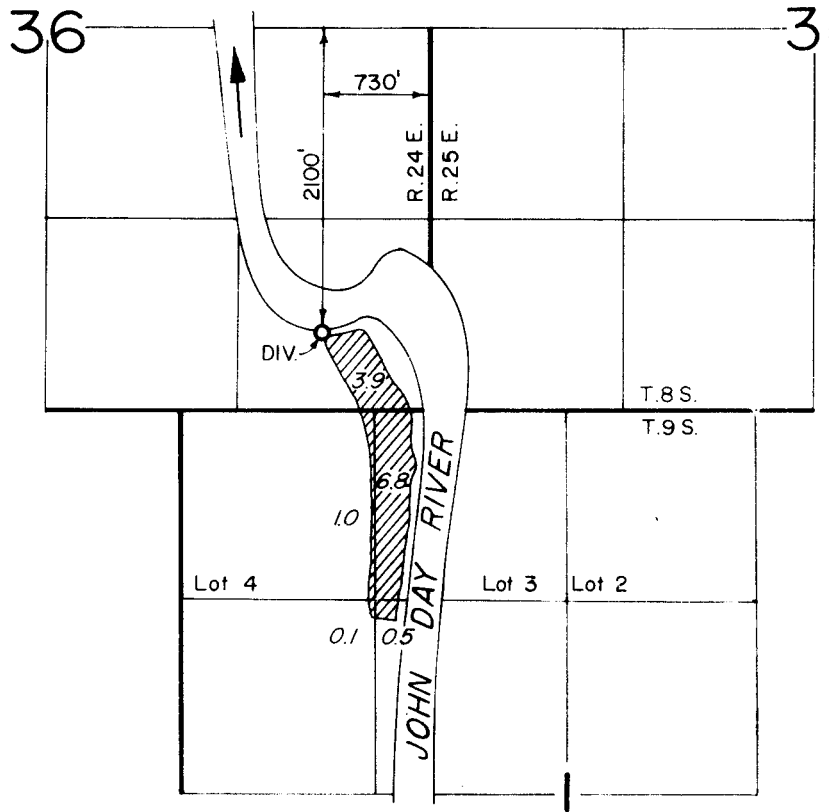

FINAL PROOF SURVEY

UNDER

Application No. 55560 Permit No. 43972.....

IN NAME OF

LeRoy & Diana Britt

Surveyed AUG.14, 1979, by *McBauer*.....