


T.6S.,R.21E.,W.M.

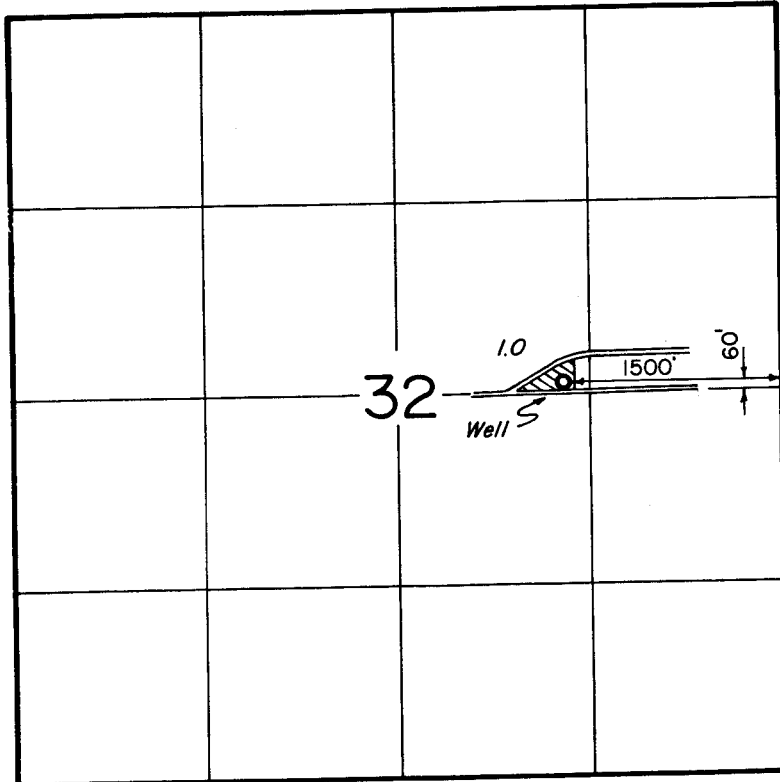

FINAL PROOF SURVEY UNDER

Application No. G-8427 Permit No. G-7814

IN NAME OF

W. C. FREEMAN

Surveyed AUG. 14, 1979, by *dlb*