


T.2S.R.6E.W.M.

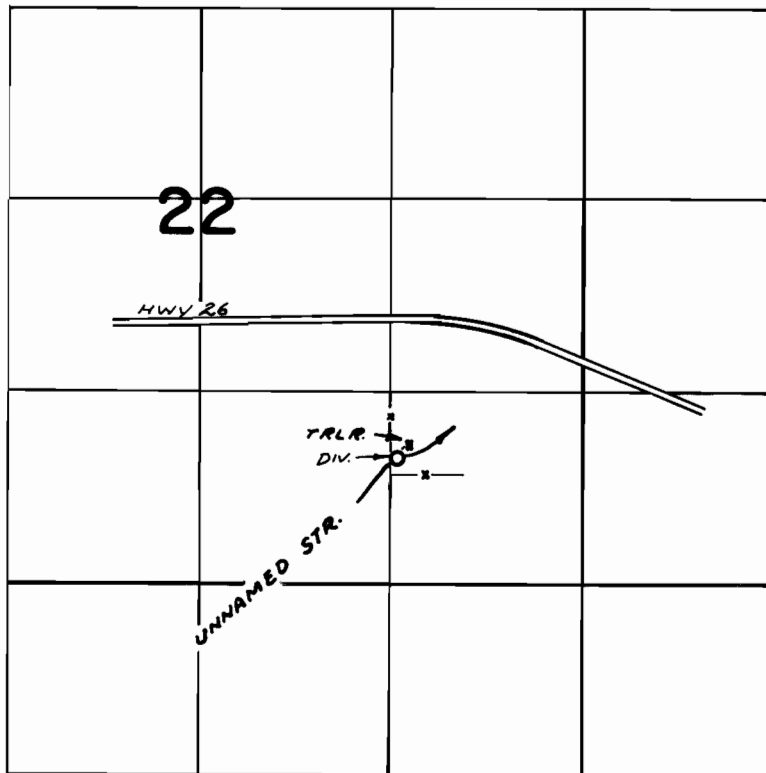

DN. PT. LOC: 850' N. & 1270' W. FROM S.E. COR. SEC. 22

FINAL PROOF SURVEY
UNDER

Application No. 53253 Permit No. 39519
IN NAME OF

JOHN D. & LUCILLE CHRISTENSEN

Surveyed MAY 7 1979, by R. G. MUCKEN