


T. 23 S., R. 4 W., W. M.

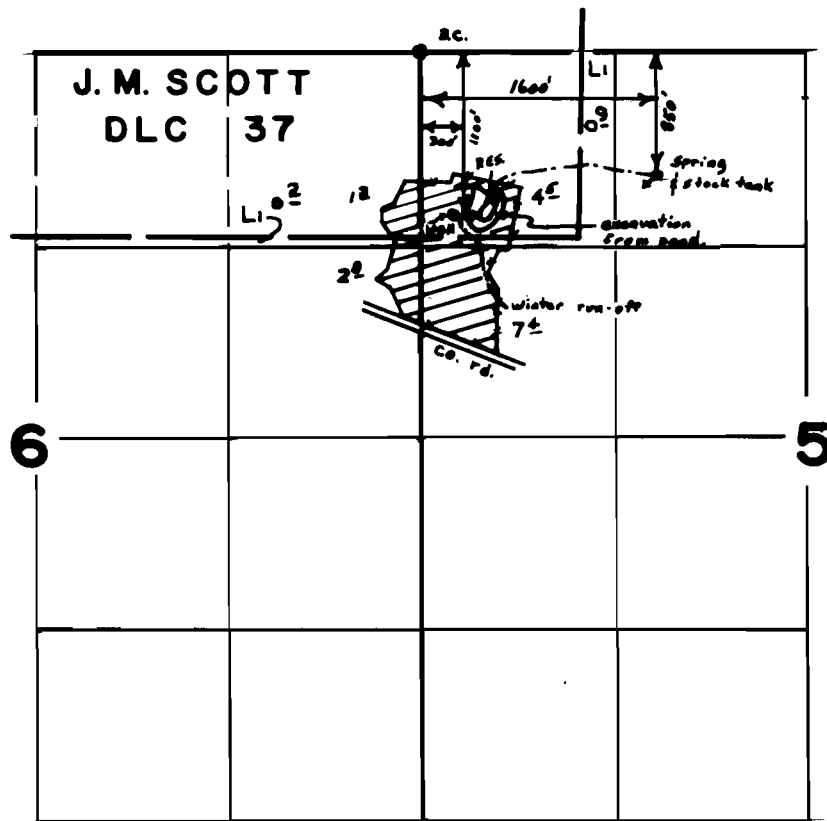

SCALE: 4" = 1 mile

FINAL PROOF SURVEY
UNDER

R-52251

R-6294

Application No. 52252. Permit No. 39324.
IN NAME OF

FREDERICK G. APPLGATE.

Surveyed SEPT. 1979, by S. DONALDSON