


T.30S. R.6W. W.M.

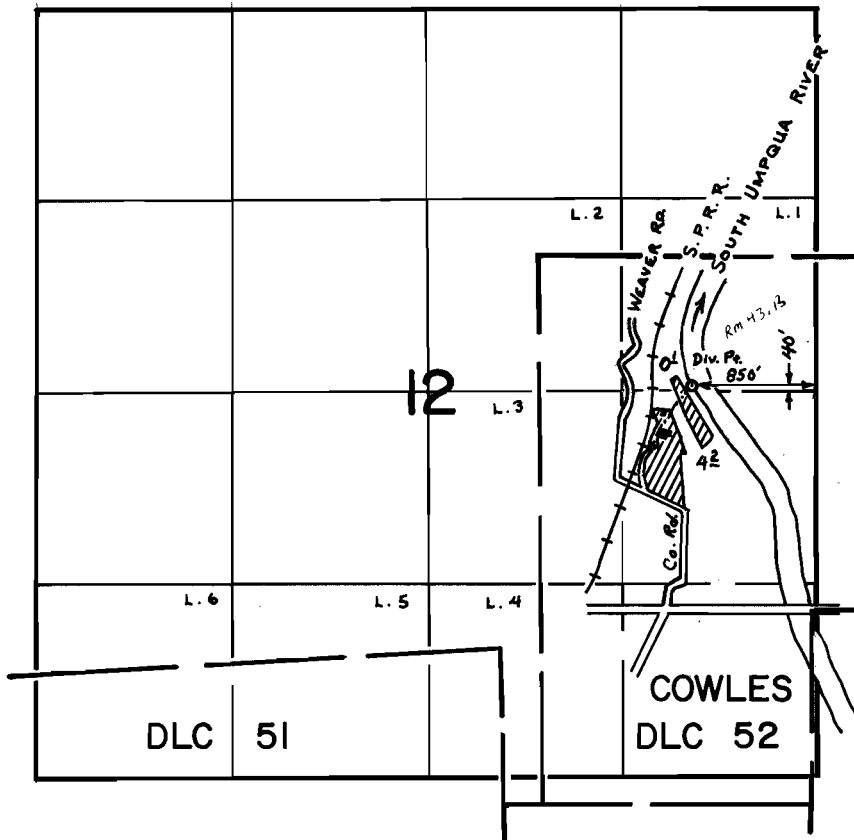

SCALE: 4" = 1 mile

FINAL PROOF SURVEY
UNDER

Application No. 50271 Permit No. 36710
IN NAME OF

DAVID B. WRIGHT

Surveyed March 12, 1979, by S. Donaldson