


T.29S., R.3W., W.M.

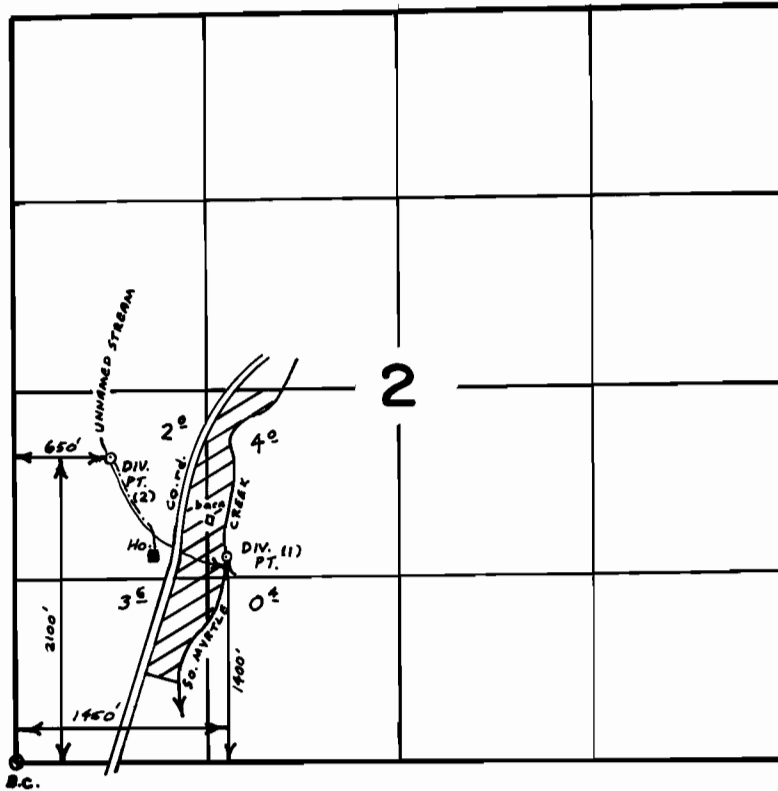

SCALE: 4" = 1 mile

FINAL PROOF SURVEY
UNDER

Application No. 50461... Permit No. 37860.
IN NAME OF

..... PAUL L. & HELEN MANN

Surveyed NOV. 8, 1979, by S. DONALDSON