


T. 21 S., R. 4 W., W. M.

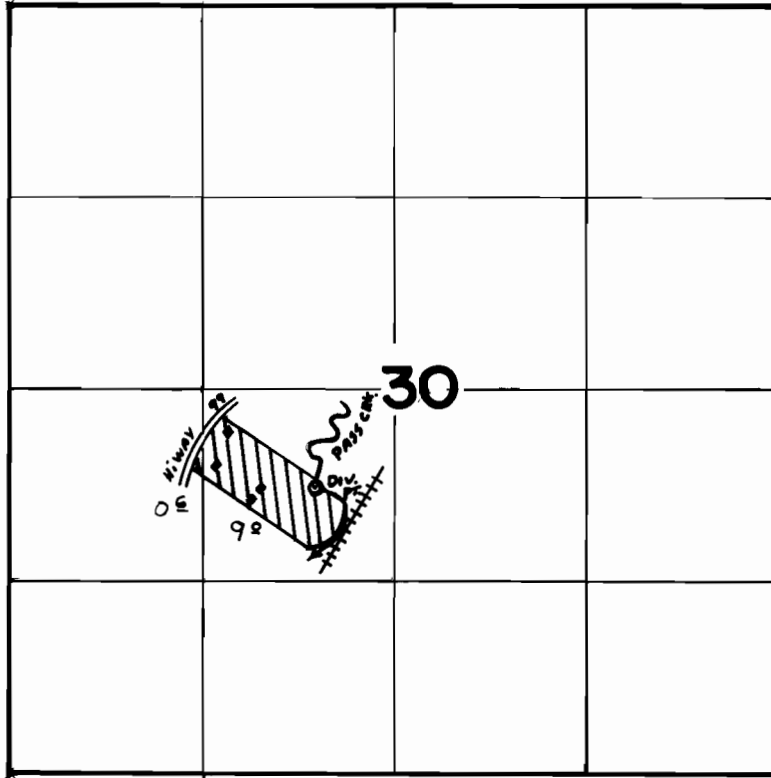

DIV. PT. : 650' S & 540' W from the center of Section 30.

SCALE : 4" = 1 mile

FINAL PROOF SURVEY UNDER

Application No. 50889.. Permit No. 38424..
IN NAME OF

.....FRED...H...CADY.....

Surveyed SEPT. 20 1979, by S...DONALDSON