


T.22 S. R.7W. W.M.

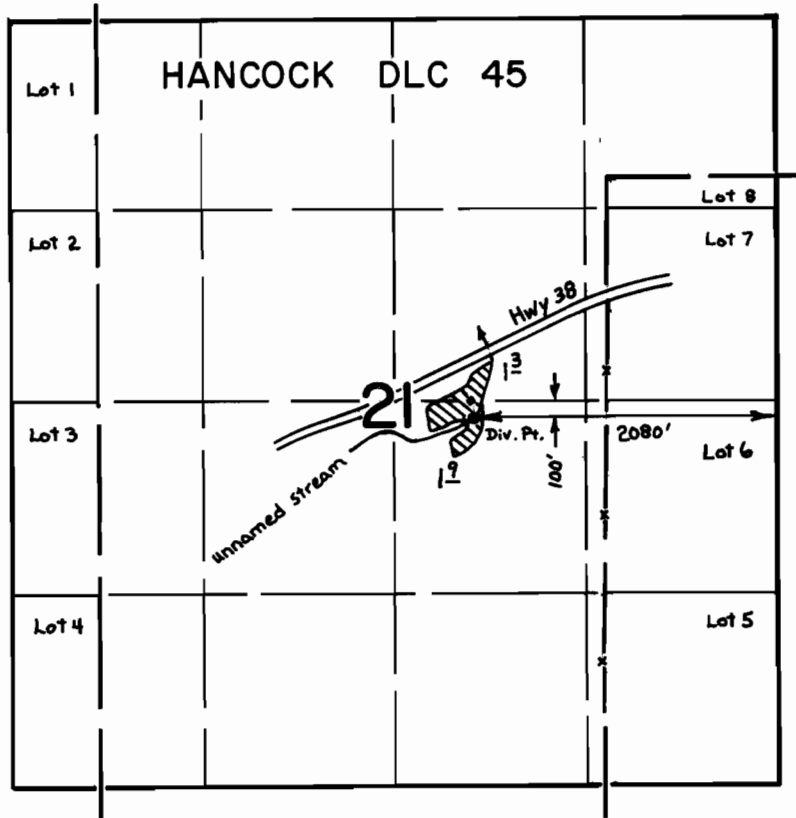

SCALE: 4" = 1 mile

FINAL PROOF SURVEY
UNDER

Application No. 51111 Permit No. 38560
IN NAME OF

ERNEST J. ALVARADO

Surveyed Aug. 29 1979. by S. Donaldson.