


T. 23 S., R. 7 W., W.M.

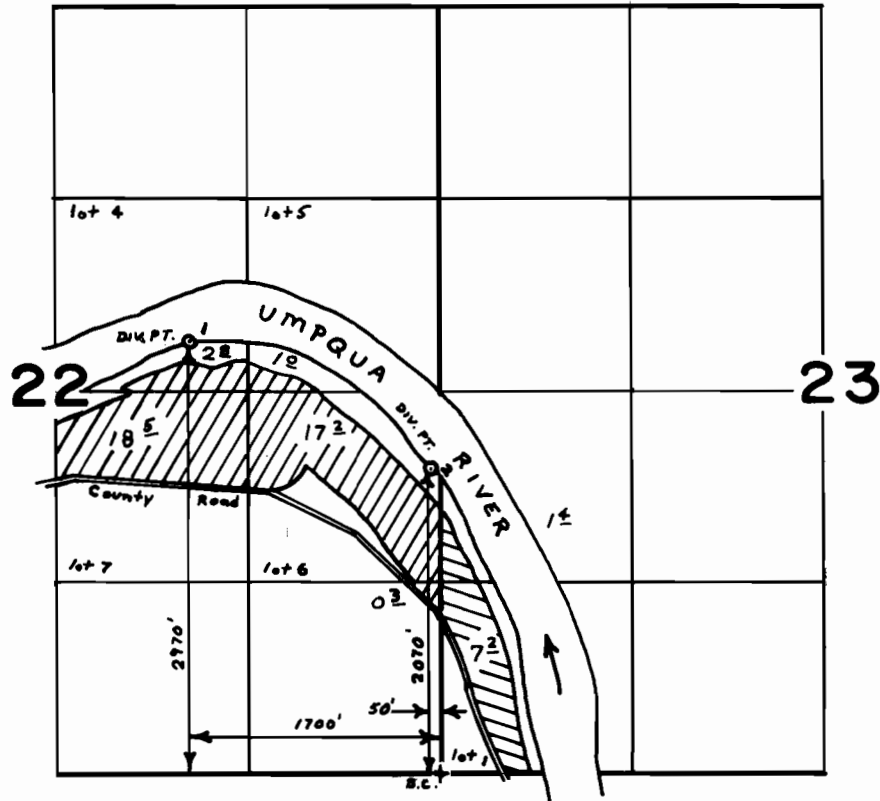

SCALE 4" = 1 mile

**FINAL PROOF SURVEY**  
UNDER

Application No. 515.17... Permit No. 386.18.  
IN NAME OF

.....BAUER.....RANCH.....INC.....

Surveyed Aug. 20, 1979, by S. Donaldson.