


T.32 S., R.5 W., W.M.

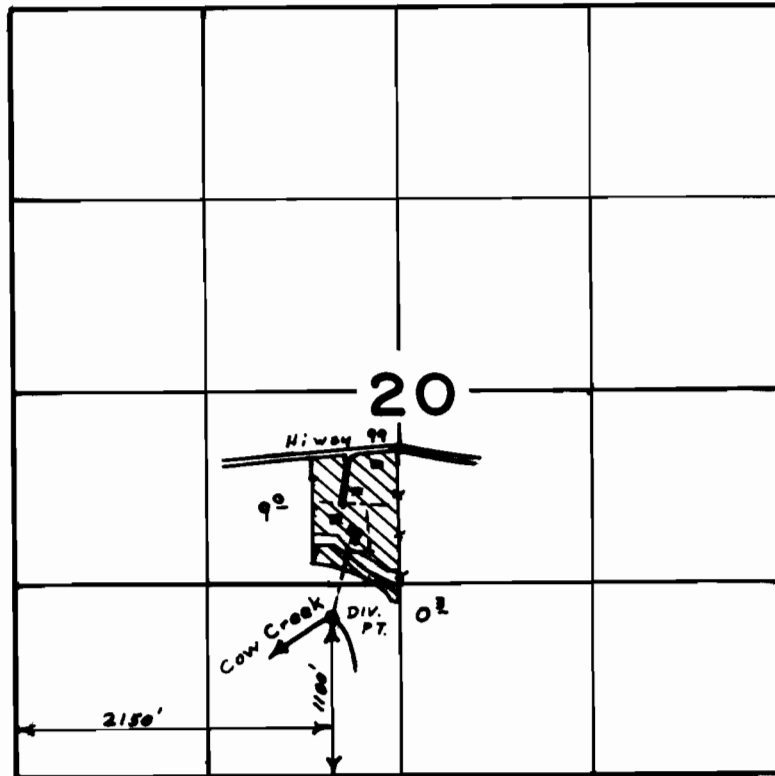

SCALE 4"=1 mile

**FINAL PROOF SURVEY**  
UNDER

Application No. 51218... Permit No. 38696  
IN NAME OF

.....BILLY.....HILL.....

Surveyed O.C.T. 15 1979, by S. DONALDSON