


T.26 S. R.6 W. W.M.

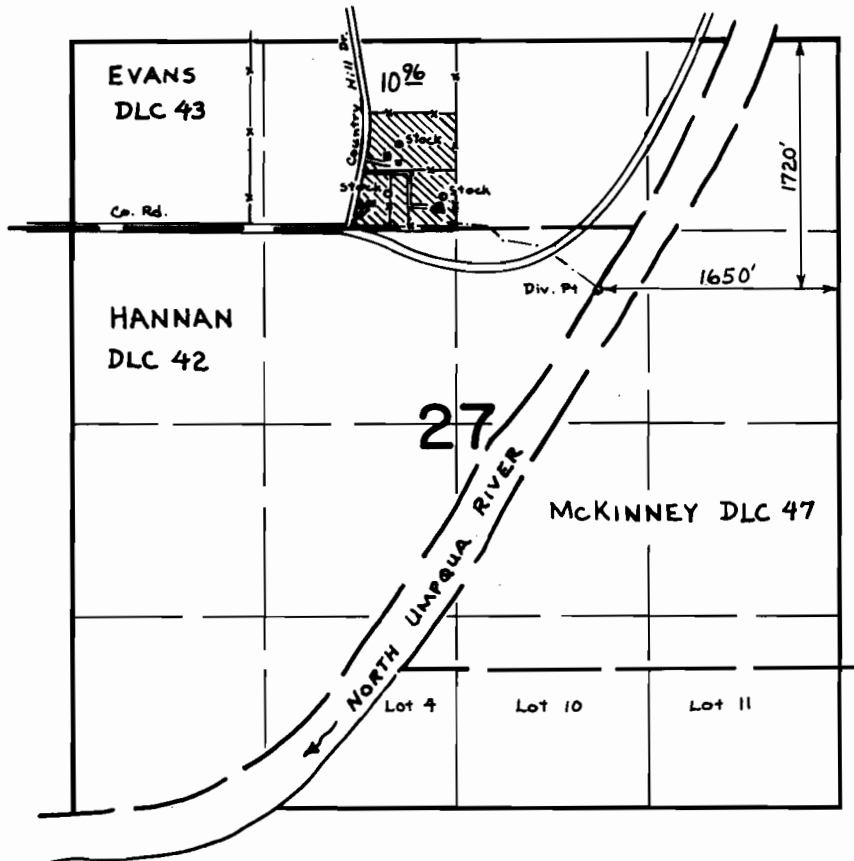

SCALE: 4" = 1 mile

FINAL PROOF SURVEY
UNDER

56636 42074
Application No. 52796.. Permit No. 39851.....
IN NAME OF

KENNETH RAY WHITTROCK

March 19, 1980 ,
Surveyed April 19, 1979., by S. Donaldson.....