


T.22 S. R.7 W. W.M.

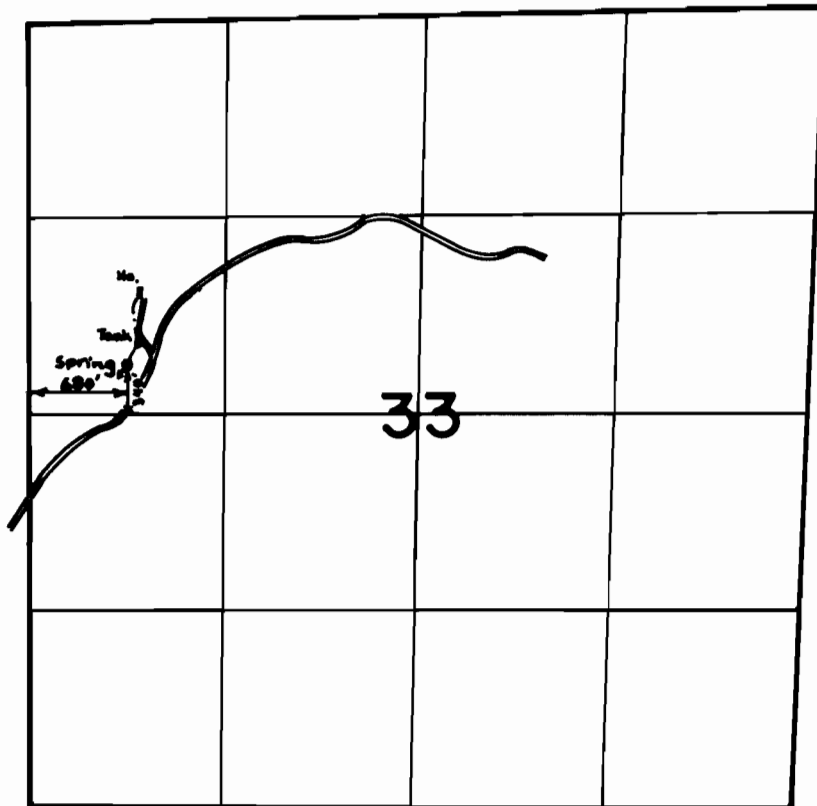

SCALE: 4" = 1 mile

FINAL PROOF SURVEY
UNDER

Application No. 53559 Permit No. 40079
IN NAME OF

JERRY B. & EUNICE E. NIX

Surveyed Aug. 23. 1979. by S. Donaldson.