


T.30 S. R.6 W. W.M.

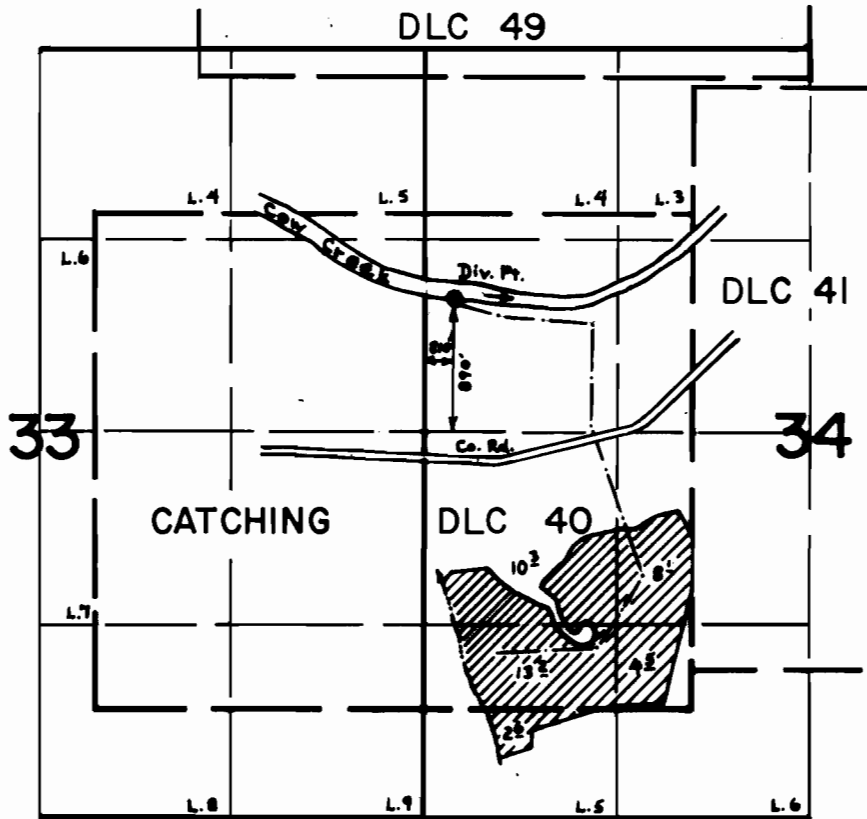

SCALE: 4" = 1 mile

FINAL PROOF SURVEY
UNDER

Application No. 53572 Permit No. 40086
IN NAME OF

EDWARD W. PARKER

Surveyed March 13, 1979, by S. Donaldson