


T.30S. R.5W. W.M.

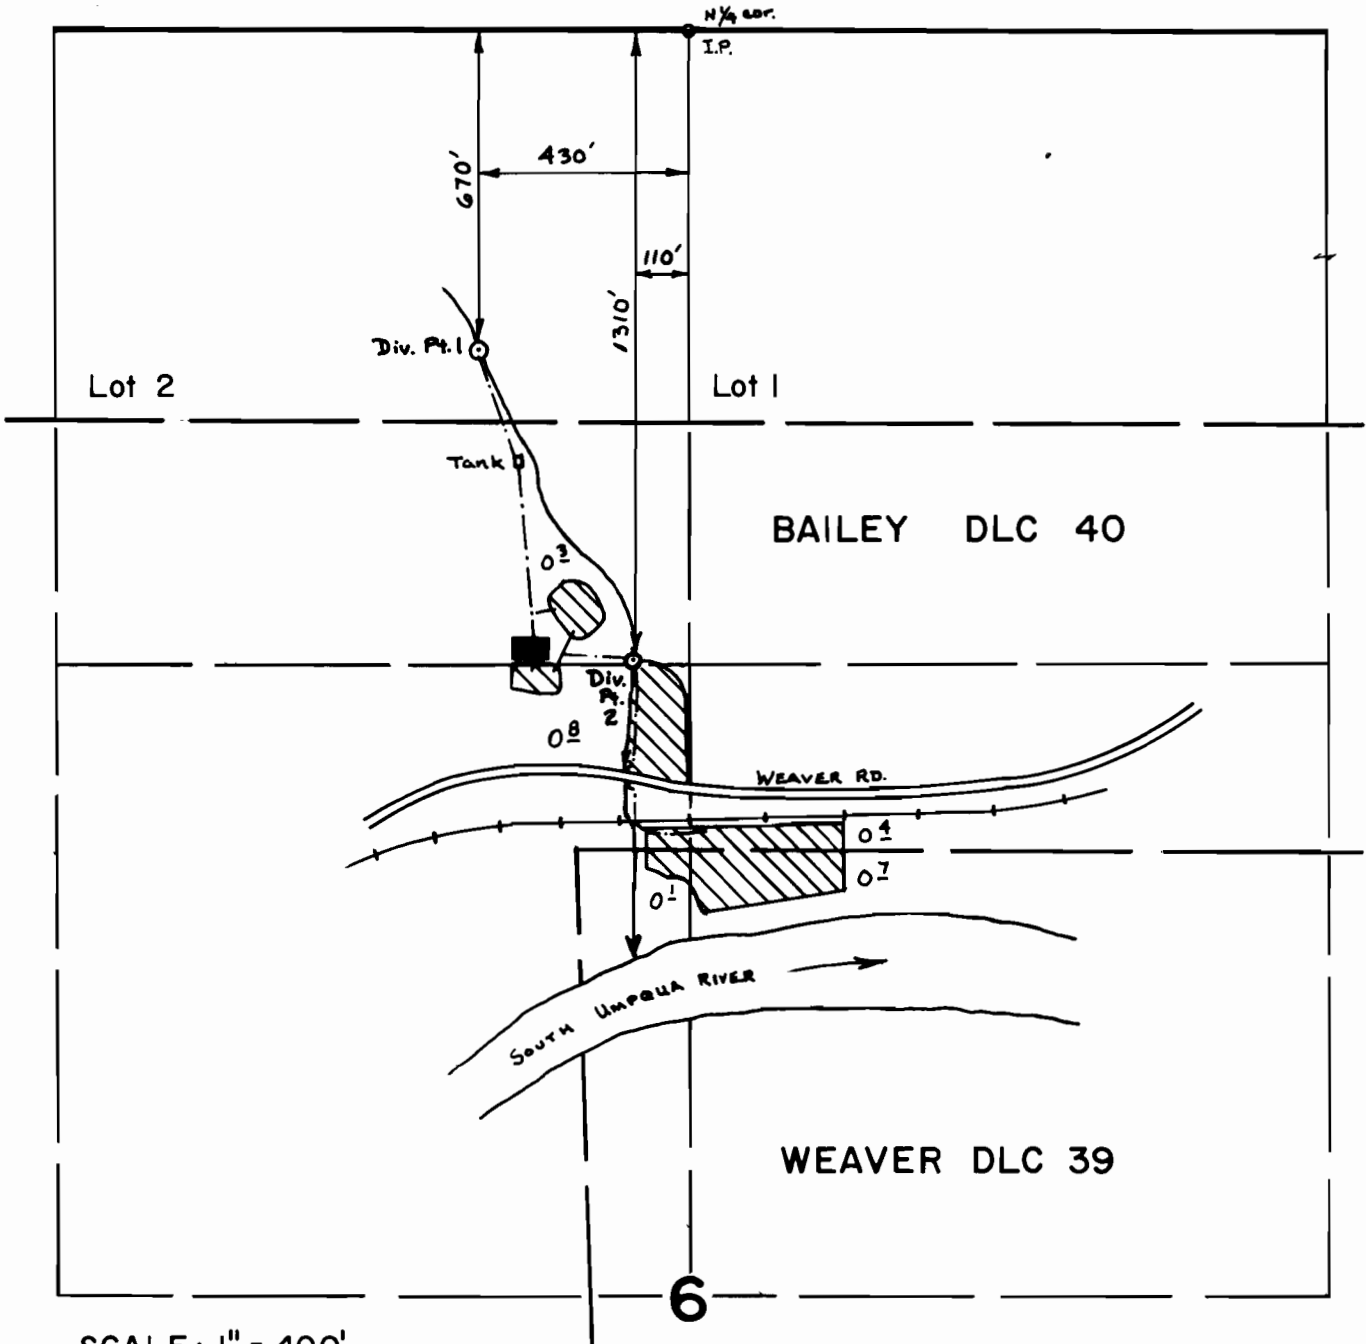

SCALE: 1" = 400'

FINAL PROOF SURVEY
UNDER

Application No. 53993 Permit No. 40263
IN NAME OF

KEITH PATRICK GAYNOR

Surveyed March 12 1979, by S. Donaldson