


T. 30S. R. 5 $\frac{1}{2}$ W. W.M.

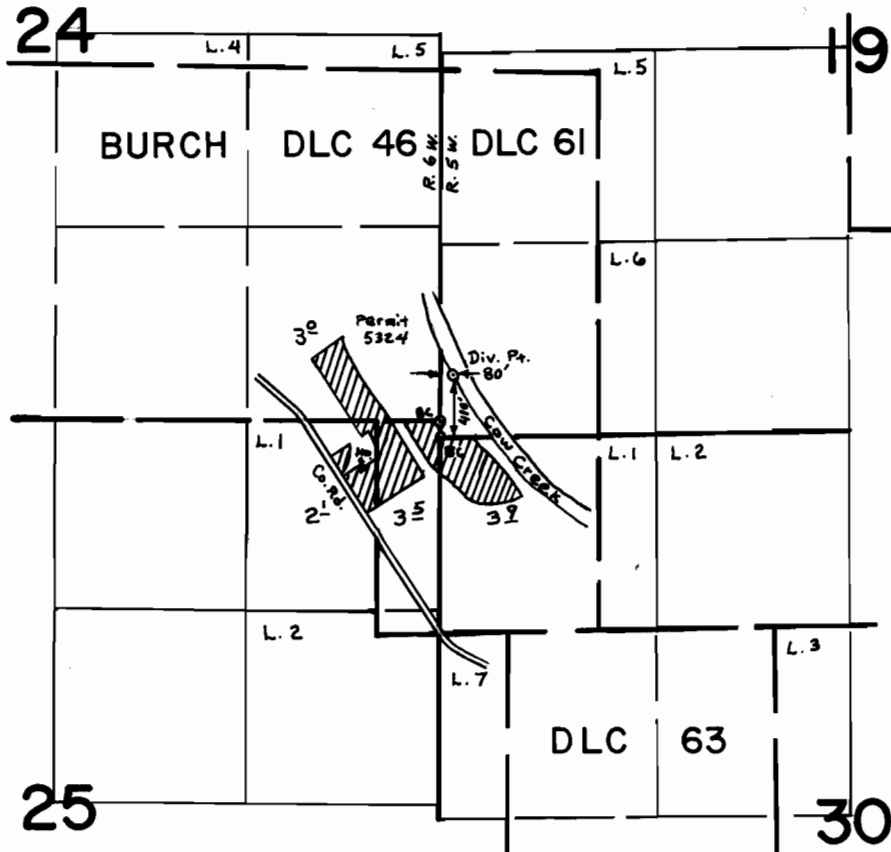

SCALE: 4" = 1 mile

**FINAL PROOF SURVEY**  
UNDER

Application No. 54042 Permit No. 40480  
IN NAME OF

RICHARD G. COLE

Surveyed March 12, 1979, by S. Donaldson