


T. 22½ 23S. R. 4W. W.M.

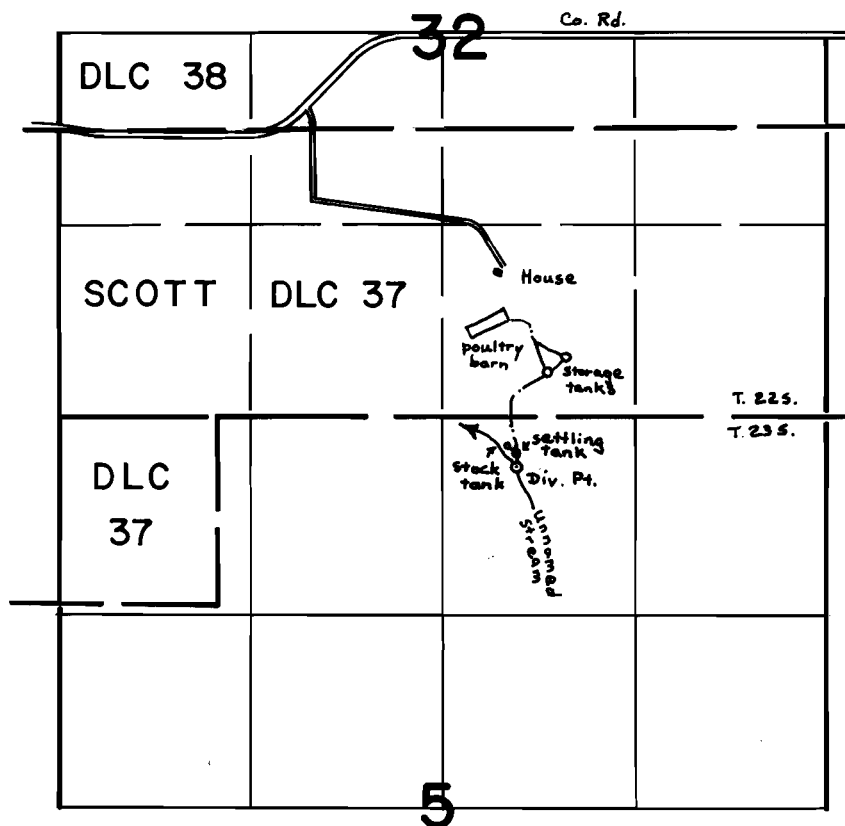

Div Pt. Located: 350's $\frac{1}{2}$ 500'E from NW cor. of Sec. 5, T. 23 S., R. 4W., W.M.

SCALE: 4" = 1 mile

FINAL PROOF SURVEY UNDER

Application No. 49535 Permit No. 40964
IN NAME OF

DAVID EBERLE

Surveyed Sept. 18, 1979. by S. Donaldson