


T. 24 S., R. 3 W., W.M.

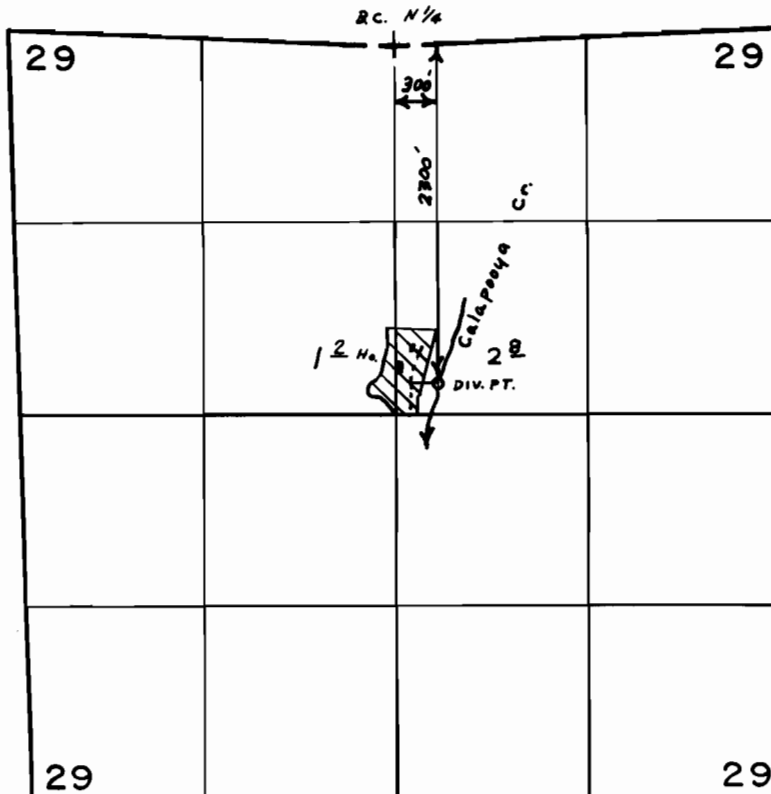

SCALE: 4" = 1 mile

FINAL PROOF SURVEY UNDER

Application No. 54954. Permit No. 41246.
IN NAME OF

.....JAMES BUTE.....

Surveyed OCT. 4, 1979, by S. DONALDSON