


T.29 S. R.4W. W.M.

Sec. 8

SW 1/4 SW 1/4

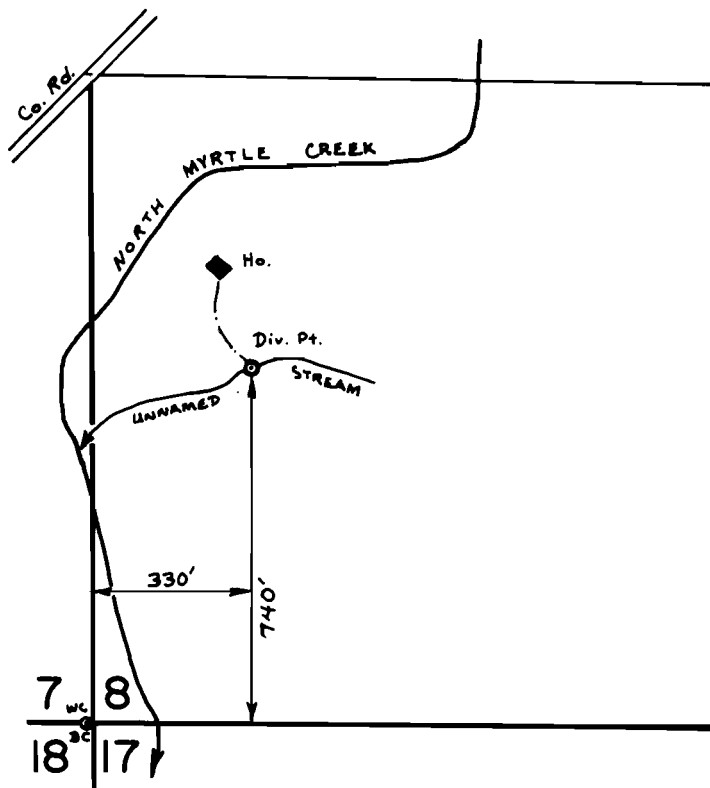

SCALE: 1" = 400'

FINAL PROOF SURVEY
UNDER

Application No. 55699 Permit No. 41722
IN NAME OF

WILLIAM L. DAVENPORT

Surveyed March 14 1978 by D. Sparks
Feb. 28 1979 S. Donaldson