2
JEER
SON

added to file.

EAGLE POINT ESTATES

LOCATED IN
SECTION 19, T26S, R4W, W.M.
DOUGLAS COUNTY
OREGON

SEEK, INC. ROSEBURG, OREGON

JANUARY, 1968

Application No. 56022
Permit No. 42062

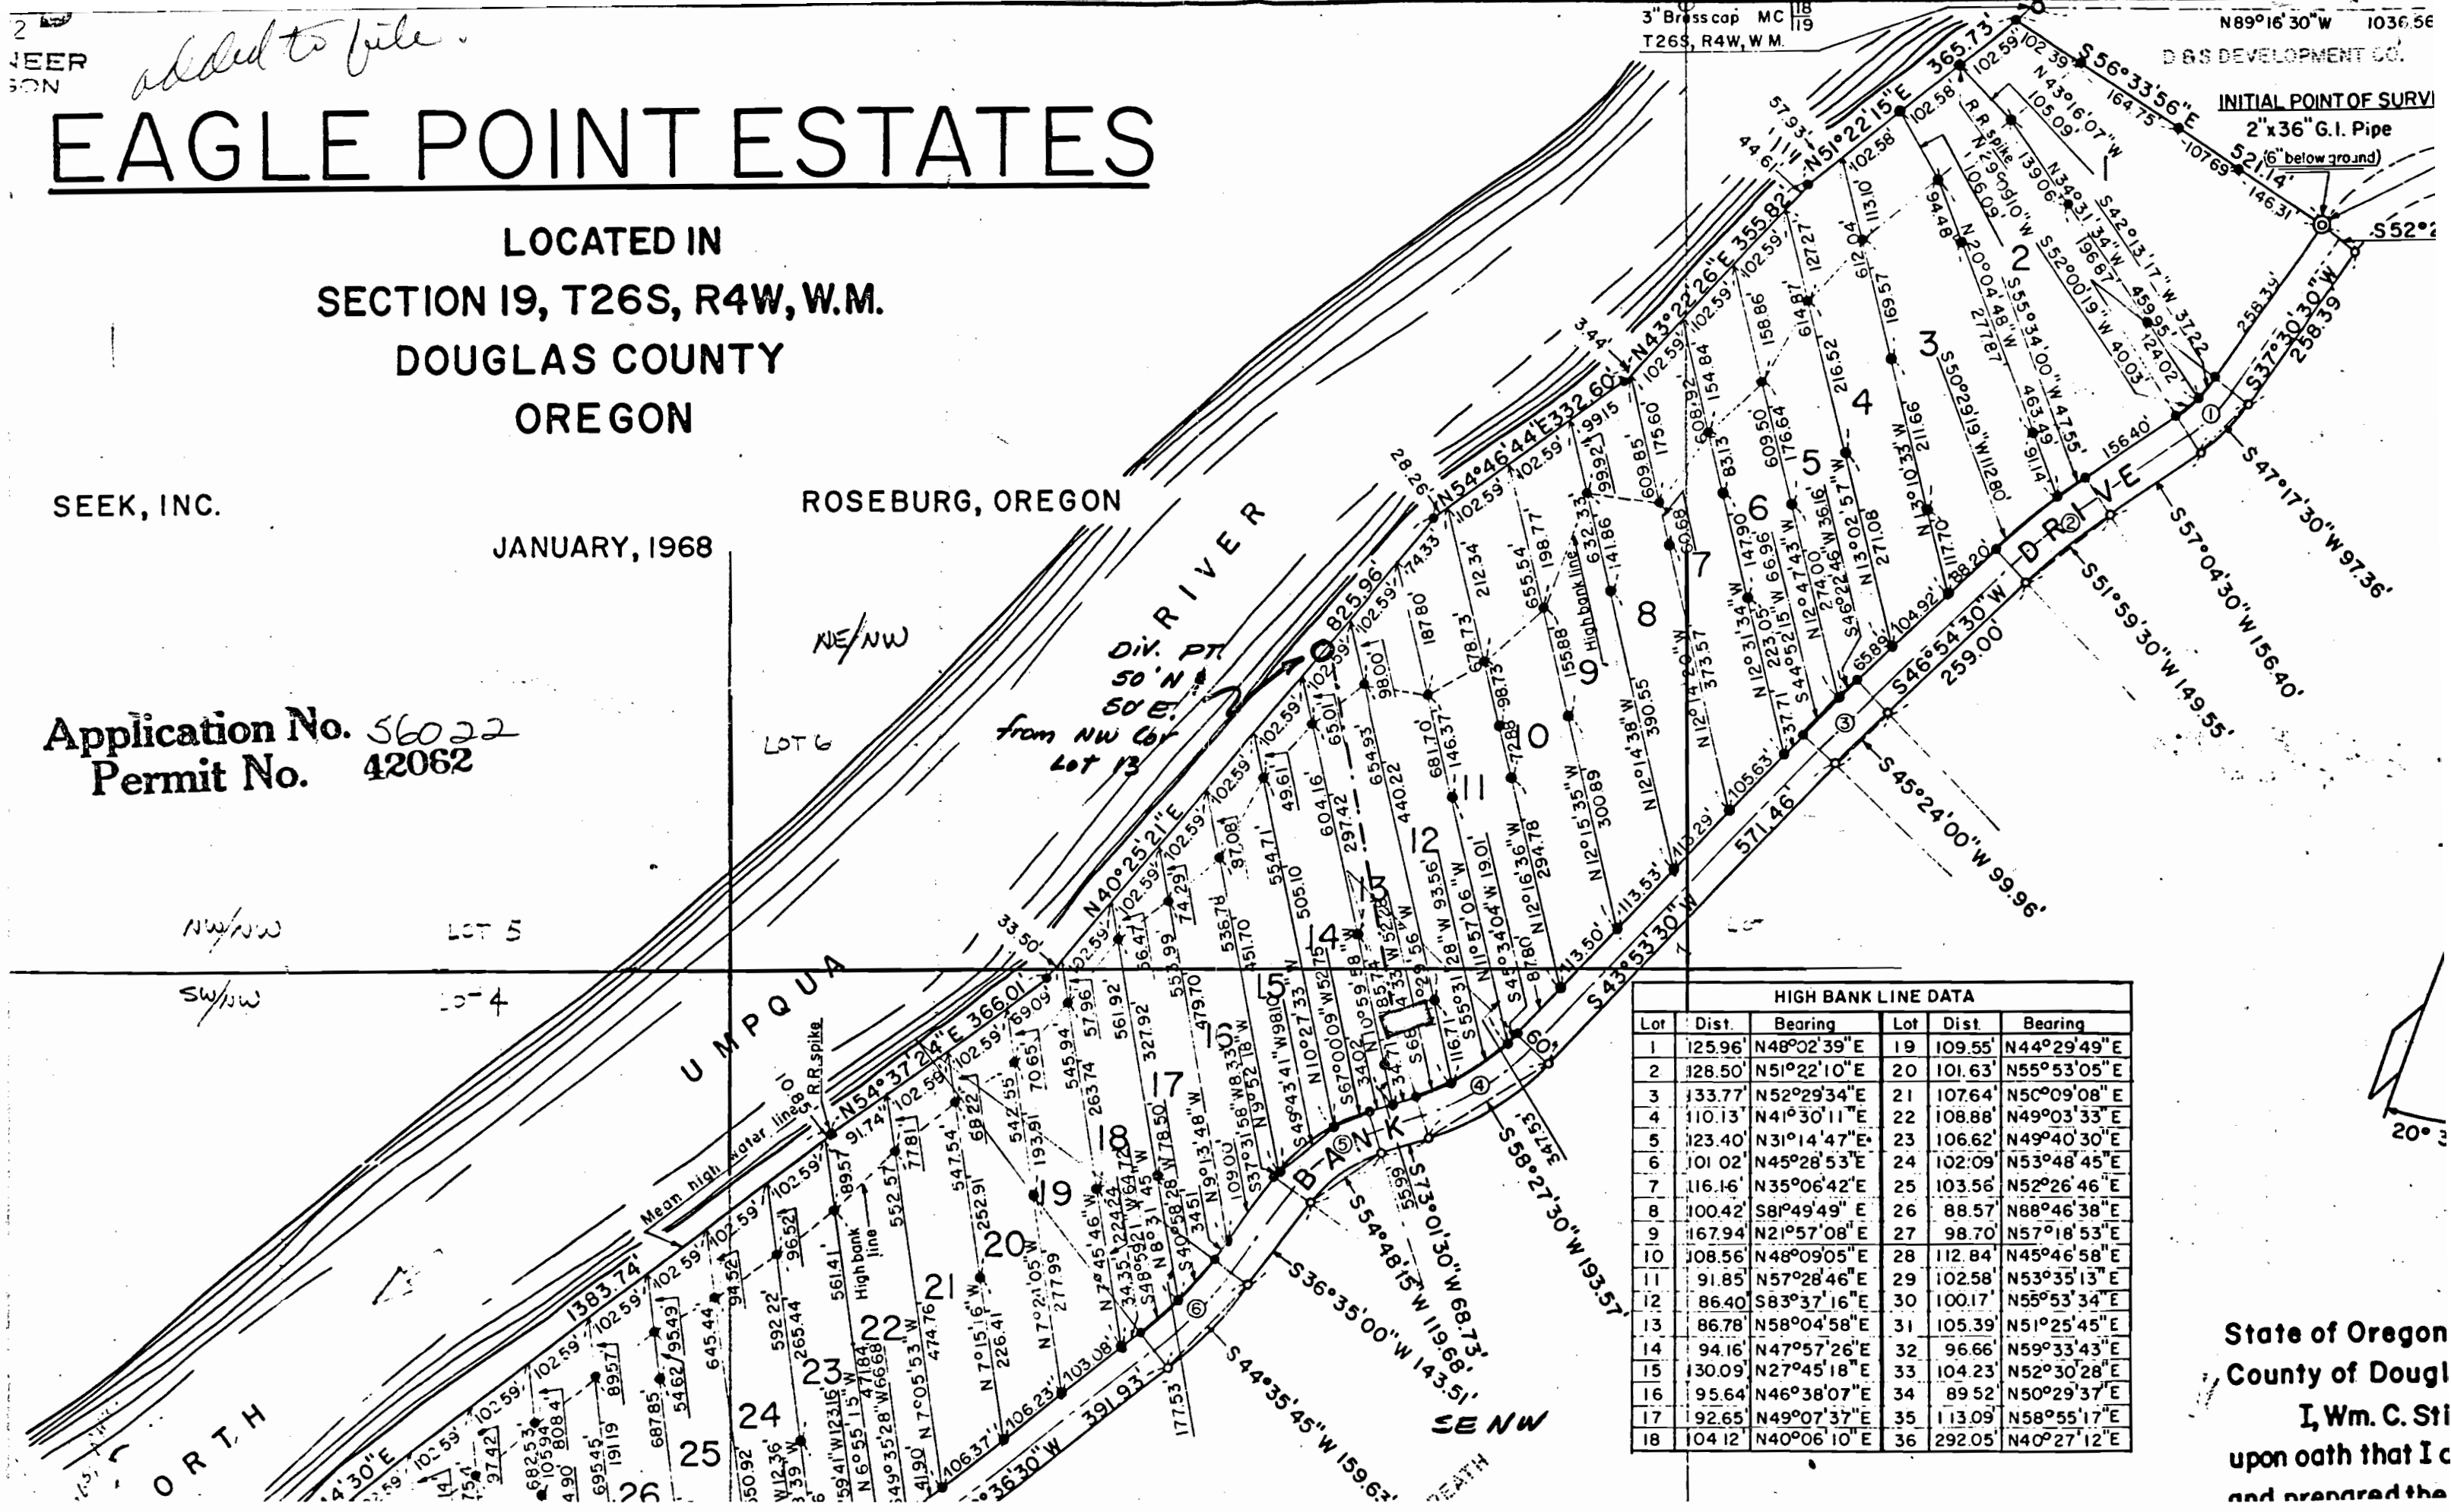

HIGH BANK LINE DATA					
Lot	Dist.	Bearing	Lot	Dist.	Bearing
1	125.96'	N48°02'39"E	19	109.55'	N44°29'49"E
2	128.50'	N51°22'10"E	20	101.63'	N55°53'05"E
3	133.77'	N52°29'34"E	21	107.64'	N5C°09'08"E
4	110.13'	N41°30'11"E	22	108.88'	N49°03'33"E
5	123.40'	N31°14'47"E	23	106.62'	N49°40'30"E
6	101 02'	N45°28'53"E	24	102.09'	N53°48'45"E
7	116.16'	N35°06'42"E	25	103.56'	N52°26'46"E
8	100.42'	S81°49'49"E	26	88.57'	N88°46'38"E
9	167.94'	N21°57'08"E	27	98.70'	N57°18'53"E
10	108.56'	N48°09'05"E	28	112.84'	N45°46'58"E
11	91.85'	N57°28'46"E	29	102.58'	N53°35'13"E
12	86.40'	S83°37'16"E	30	100.17'	N55°53'34"E
13	86.78'	N58°04'58"E	31	105.39'	N51°25'45"E
14	94.16'	N47°57'26"E	32	96.66'	N59°33'43"E
15	130.09'	N27°45'18"E	33	104.23'	N52°30'28"E
16	95.64'	N46°38'07"E	34	89.52'	N50°29'37"E
17	92.65'	N49°07'37"E	35	113.09'	N58°55'17"E
18	104.12'	N40°06'10"E	36	292.05'	N40°27'12"E

State of Oregon
County of Dougl
I, Wm. C. Sti
upon oath that I c
and prepared the