


T.26S. R.4W. W.M.

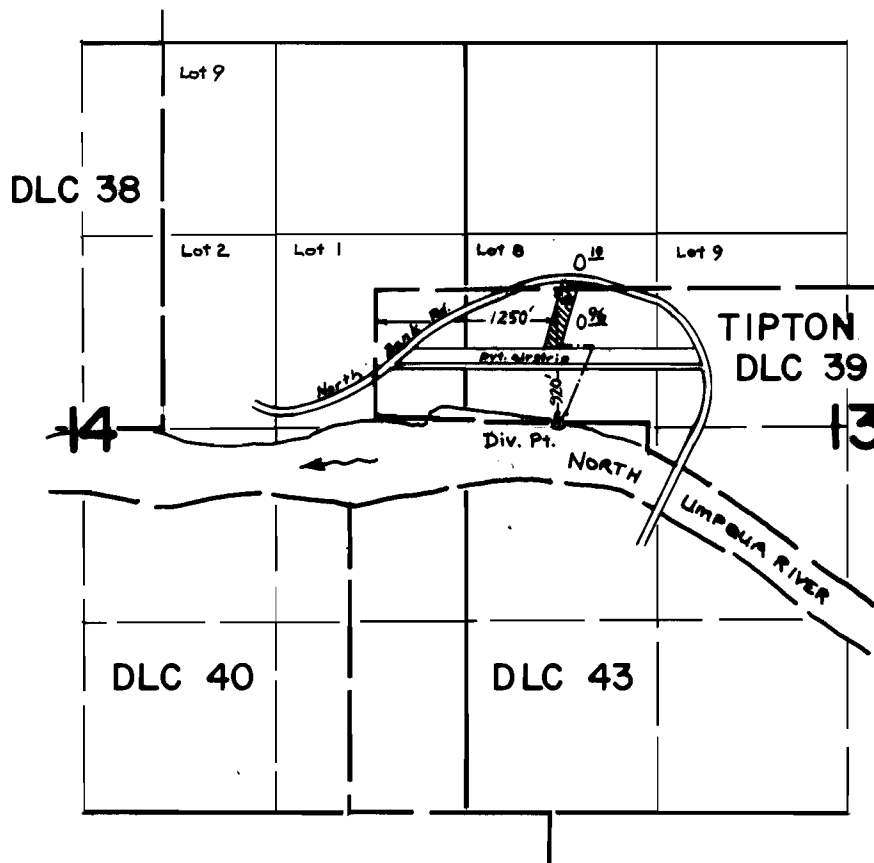

SKY PARK ESTATES
Block 1 Lot 8

SCALE: 4" = 1 mile

FINAL PROOF SURVEY
UNDER

Application No. 56460 Permit No. 42071
IN NAME OF

KEN ISHIBASHI

Surveyed April 24, 1979, by S. Donaldson