


T.30S. R.6W. W.M.

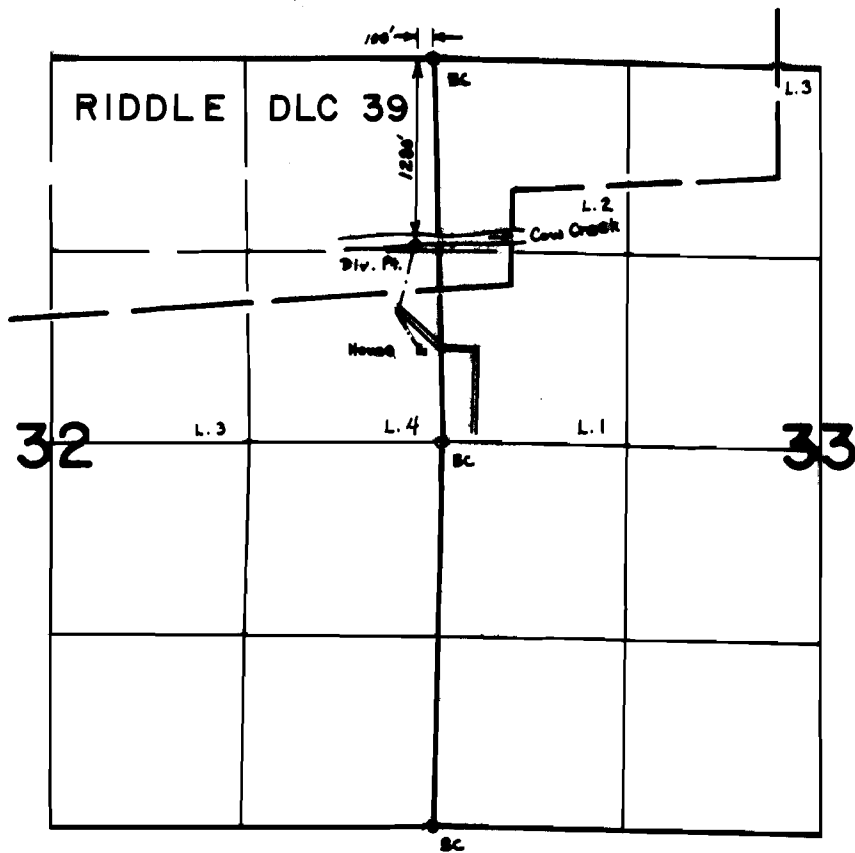

SCALE: 4" = 1 mile

FINAL PROOF SURVEY
UNDER

Application No. 56415 Permit No. 42154
IN NAME OF

THEODORE L. FAVER

Surveyed March 12, 1979, by S. Donaldson