


T.26S. R.5W. W.M.

Sec. 16

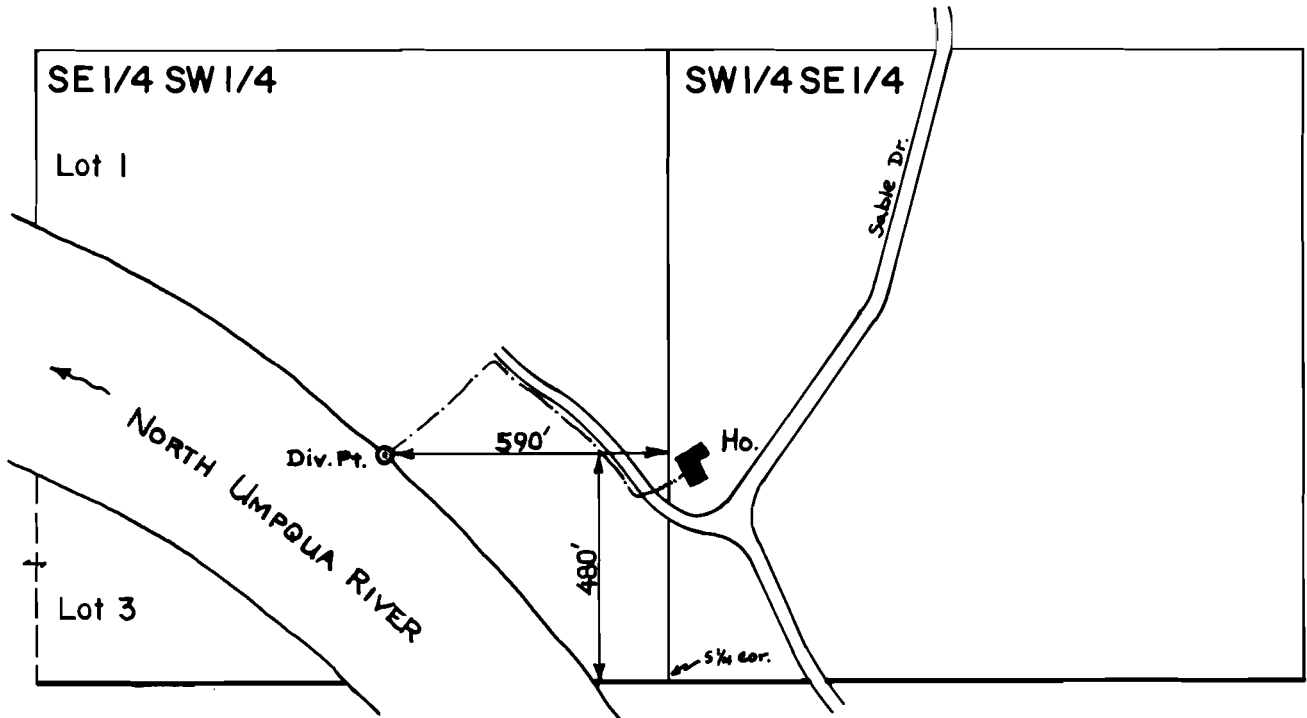

SCALE: 1" = 400'

FINAL PROOF SURVEY
UNDER

Application No. 56850 Permit No. 42674

IN NAME OF

ROBERT & ELNORA TRUTNER

Surveyed April 30, 1979, by S. Donaldson