


T.30S. R. 3&4W. W.M.

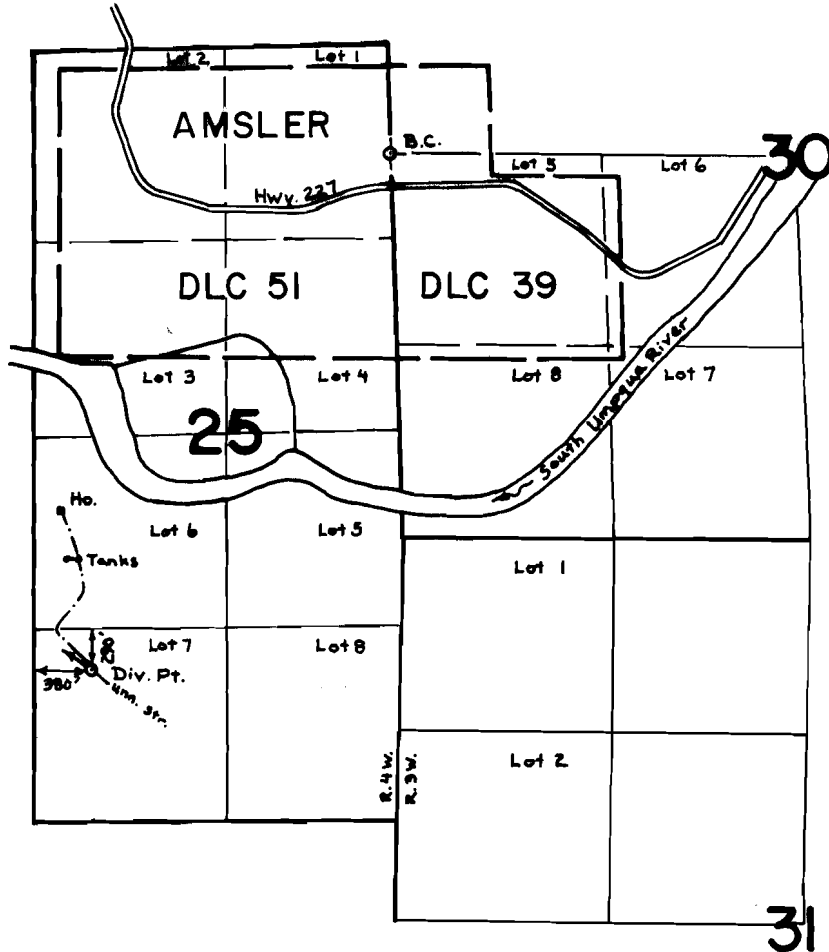

SCALE: 4" = 1 mile

FINAL PROOF SURVEY
UNDER

Application No. 56983 Permit No. 42900
IN NAME OF

PETER ERIC POLLACZEK

Surveyed March 19, 1979., by S. Donaldson....