


T.30S. R. 3&4W. W.M.

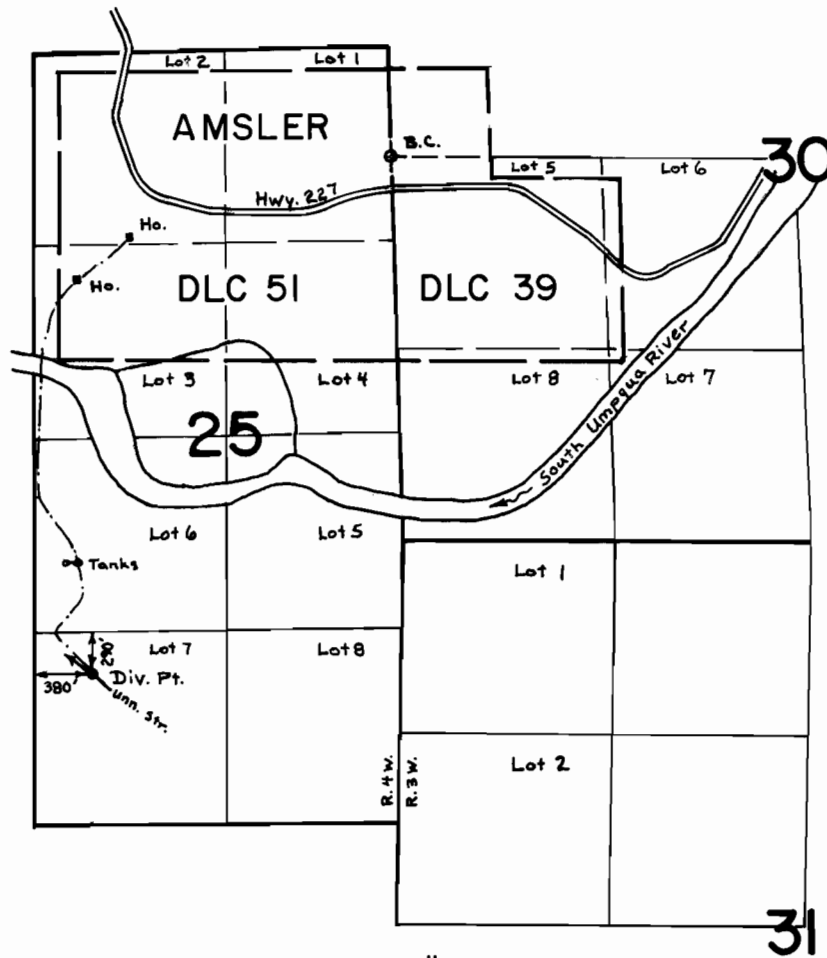

SCALE: 4" = 1 mile

FINAL PROOF SURVEY
UNDER

Application No. 57210... Permit No. 43016...
IN NAME OF

ARTHUR C. MILLER

Surveyed March 19, 1979., by S. Donaldson.....