


T. 30 S. R. 6 W. W.M.

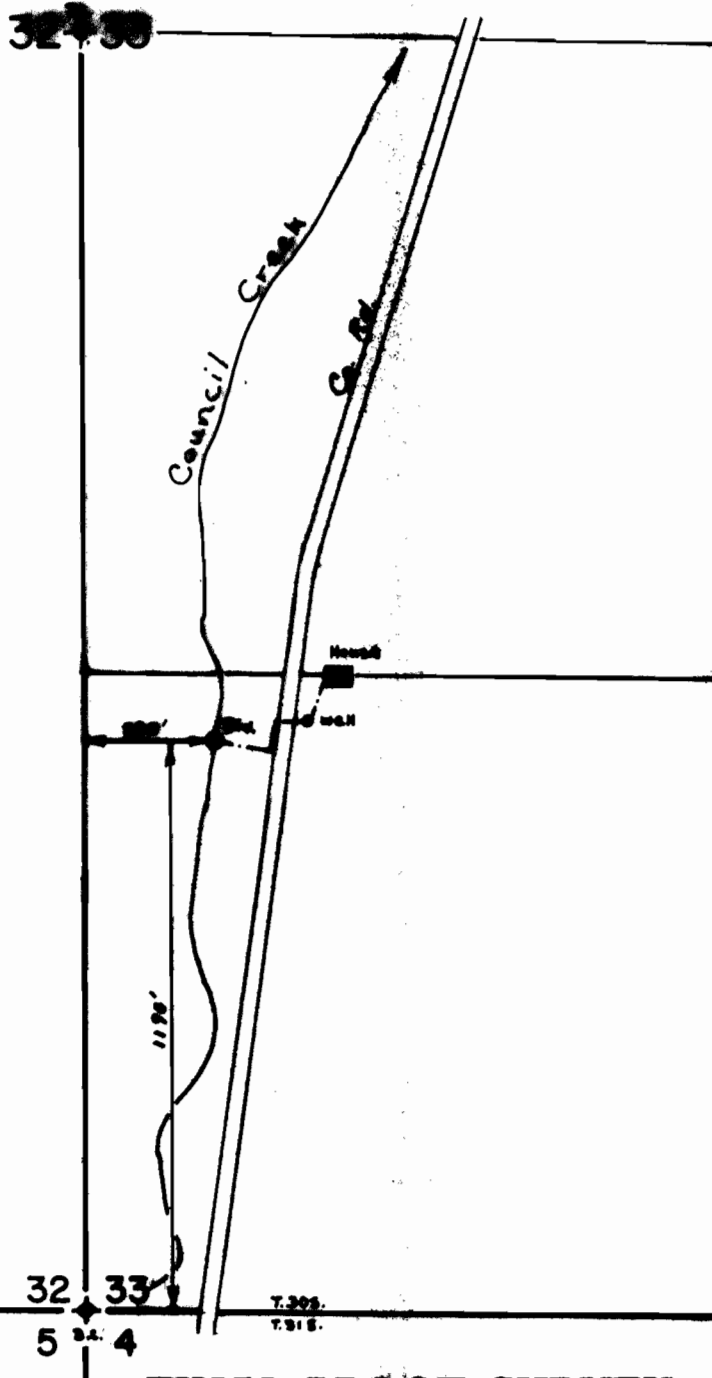

Scale: 1" = 400'

**FINAL PROOF SURVEY  
UNDER**

Application No. 57228 Permit No. 43122  
IN NAME OF

JESSE J. YOUNGBLOOD

Surveyed Oct. 25 1979, by S. Donaldson